

MICHIGAN  
DEPARTMENT OF CONSERVATION  
FORESTRY DIVISION

# LAND CORNER RECORD

T. 37 N. R. 5 W.


Emmet COUNTY

DESCRIPTION OF CORNER Section corner common to Sections 31 - 32 on south boundary of township

CORNER MONUMENT Set 1" pipe with 4" aluminum cap, below surface

DATE MONUMENT PLACED AND WITNESSED June 25, 1962

WITNESSES TO CORNER.....

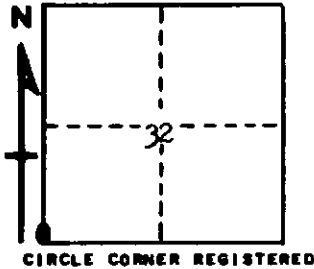

24" Elm N 81 E 143.5'

Power Pole N 25 W 80.6'

AND

DESCRIPTION IN DETAIL AS TO HOW CORNER WAS LOCATED AND IDENTIFIED OR RESTORED.

This corner was found while making a survey in this area. Found old crockery and broken brick at corner 1' below surface of road. Falls in centerline of E - W road and in line with old township road north. Properly located with reference to closing corner also.

Corner to Sections 5 - 6, T 36 N, R 5 W is 12 links west.

SURVEYOR'S SEAL

SIGNED

*Kenneth J. Ostling*  
REGISTERED LAND SURVEYOR

DATE June 27, 1962