

MICHIGAN
DEPARTMENT OF CONSERVATION
FORESTRY DIVISION

LAND CORNER RECORD


T. 37 N.R. 5 W
T 38 NR 5 W Emmet COUNTY

DESCRIPTION OF CORNER Section corner common to Sections 5-6-31-32

CORNER MONUMENT Chiseled Cross in blacktop

DATE MONUMENT PLACED AND WITNESSED April 28, 1961

WITNESSES TO CORNER.....

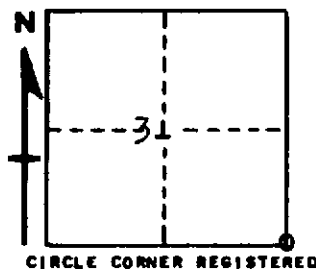

4" Cedar	-	N46W	-	54.3 feet
10" Aspen	-	N48E	-	52.8 feet
AND				

DESCRIPTION IN DETAIL AS TO HOW CORNER WAS LOCATED AND IDENTIFIED OR RESTORED.

This corner was established at the apparent centerline intersection of roads east, west and south. Could find no previous corner and considered this point best available evidence. Checks measurement north to lake and to 1/4 line fence east.

SURVEYOR'S SEAL

SIGNED Kenneth J. Oelling DATE 5/24/61
REGISTERED LAND SURVEYOR