

SURVEY & REMONUMENTATION

MAR 16 1994

LAND CORNER RECORDATION CERTIFICATE
Filing Requirement of Act 74, Mich. P.A. 1970

STATE OF MICHIGAN
EMMET COUNTY
RECORDED

1994 FEB 14 AM 10:14

For corners in EMMET (County)
COMMISSION

Located in:
CROSS VILLAGE
37N 6W

Corner Code #
E-3


Glenna B. Sipe
REGISTER OF DEEDS

- | | | | |
|------------------------------------|---|---|-------|
| 1. Public Land Survey | T | R | _____ |
| ECRP #28 | T | R | _____ |
| | T | R | _____ |
| | T | R | _____ |
| 2. Property Controlling in Section | S | T | R |
| | S | T | R |
| 3. Miscellaneous Property in Sec. | S | T | R |
| | S | T | R |

LIBER A
PAGE 19

Register of Deeds Stamp & File Number

4. Lot No. _____, Recorded Plat _____
5. Private Claims _____

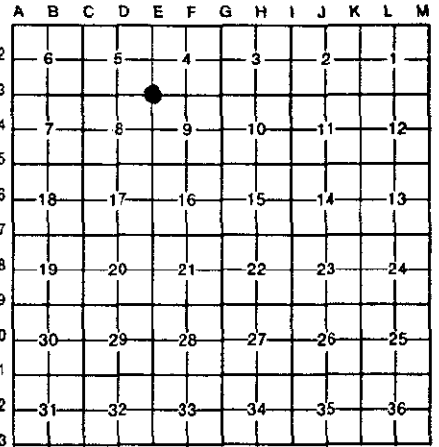

I, Richard E. Oelke, on 30 December, 1993, do hereby certify that under requirements of P.A. 74, Michigan P.A. of 1970, the corner points mentioned in lines 1 and 2 above were in conformance with regulations and rules therefore as required in the current manual of survey instructions of the United States Department of the Interior, Bureau of Land Management or by a decree of a Court of Law and/or that the corner points mentioned in lines 3, 4 and 5 above were in conformance with the rules of the Michigan Board of Land Surveyors or by a Decree of a Court of Law; established, re-established, monumented, re-monumented, recovered, found as expressed below:

NOTE: Not more than 4 corners, all in the same town and range, may be recorded on this certificate.

A. Description of original monument and accessories and/or subsequent restoration:

E-3, Section corner 4,5,8,9 T37N, R6W

- 1840 GLO Set cedar post N48°W, 041ks, 10" beech; S20°E, 071ks, 8" beech
- 1968 Irish Set 1" iron pipe from fences. (1) N30°W, 29.0', PP "PN3 1924-8"
(2) S45°W, 40.4', sign post
- 1968 Bidstrup Survey for Lojewski, used 1" IP.
- 1973 Bidstrup Survey for Jesick, used 1" IP.
- 1987 O'Neill LCRC, Liber 2, page 236, Fd. 1" iron pipe at the intersection of Division and Gully Roads.
(3) N26°E, 55.61', 12" beech tagged 30095 in E face
(4) S24°W, 82.74', 4" ironwd tagged 30095 in E face
(5) S61°W, 97.06', 10" beech tagged 30095 in E face
(6) N26°W, 28.92', PP tagged 30095 in E face

B. Description of corner evidence found and/or method applied in restoring or reestablishing corner:

E-3, Section corner 4,5,8,9 T37N, R6W

Found 1" iron pipe flush with the surface. Also found RR spike N58°W, 1.07', 1.1' below surface in old road bed. This pipe fits existing occupation.

- S27°W, 82.72', fd(4) 4" ironwood tagged 30095 in E face
- S64°W, 97.03', fd(5) 10" beech tagged 30095 in E face
- N24°W, 28.90', fd(1)(6) power pole "192A-8" tagged 30095 in E face

C. Description of monument for corner and accessories established to perpetuate locating the position of the corner:

E-3, Section corner 4,5,8,9 T37N, R6W

At the 1" iron pipe, set a 2" diam., 30" long, PVC pipe with a base magnet and a standard brass Emmet County Survey Remonumentation Program cap. This position is accepted as a careful and faithful reestablishment of the position of the original corner.

- S84°E, 318.70', power pole "7M" tagged 33983 in N face
- S27°W, 82.72', fd(4) 4" ironwood tagged 30095 in E face
- S64°W, 97.03', fd(5) 10" beech tagged 30095 in E face
- N24°W, 28.90', fd(1)(6) power pole "192A-8" tagged 30095 in E face



Signed by RICHARD E. OELKE Date 14 JANUARY 1994
Surveyor's Michigan License No. 33983