

MAR 13 2000

STATE OF MICHIGAN
EMMET COUNTY
RECORDED

SECTION

LAND CORNER RECORDATION CERTIFICATE
Filing Requirement of Act 74, Mich. P.A. 1970

99 DEC 28 AM 9:36

For corners in

EMMET (County) Located In: READMOND TOWNSHIP Corner Code # F-3

1. Public Land Survey ECRP #200 T 37N R 6W

2. Property Controlling in Section S T R

3. Miscellaneous Property in Sec. S T R

4. Lot No. , Recorded Plat

5. Private Claims

Glenn B. Sizer
REGISTER OF DEEDS

LIDER A
PAGE 314

Register of Deeds Stamp & File Number

I, Richard E. Oelke, in a field survey on 10 December, 1999 do hereby certify that under requirements of P.A. 74, Michigan P.A. of 1970, the corner points mentioned in lines 1 and 2 above were in conformance with regulations and rules therefore as required in the current manual of survey instructions of the United States Department of the Interior, Bureau of Land Management or by a decree of a Court of Law and/or that the corner points mentioned in lines 3, 4 and 5 above were in conformance with the rules of the Michigan Board of Land Surveyors or by a Decree of a Court of Law; established, re-established, monumented, re-monumented, recovered, found as expressed below:

1	A	B	C	D	E	F	G	H	I	J	K	L	M
2		6		5		4		3		2		1	
3						●							
4		7		8		9		10		11		12	
5													
6		18		17		16		15		14		13	
7													
8		19		20		21		22		23		24	
9													
10		30		29		28		27		26		25	
11													
12		31		32		33		34		35		36	
13													

NOTE: Not more than 4 corners, all in the same town and range, may be recorded on this certificate.

A. Description of original monument and accessories and/or subsequent restoration:

Abstract: GLO set post in 1840's. 1) N 45°E 5L 8" Elm
2) S 4°W 43L 18" Sugar

1998 J. Young found 1-1/4", 1' below ground, 2.5' S. of centerline of Division Road, +/-3' W. of old fence to the S.

B. Description of corner evidence found and/or method applied in restoring or reestablishing corner:

Found: 1-1/4" well point, 2' long, +/-3' S. of centerline of Division Rd. and +/-3' W. of old fence to the S. Dug holes in the centerline of road opposite fence to the south and also one approximately 18' W. at extension of old fence to the S. found nothing.

- 1) S 34° E, 49.76', 6" red pine, tagged 30095, in E. face
- 2) S 72° W, 83.14', 20" maple, tagged 30095, in N. face
- 3) N 74 °W, 184.10', 8" birch clump, tagged 30095 in NE face
- 4) N 19° W, 32.00', pp, tagged 30095, in E. face

APPROVED LAND CORNER
P.A. 345 OF 1990
Emmet County


R.E. OELKE

C. Description of monument for corner and accessories established to perpetuate locating the position of the corner: ECRP REP. 12-23-99

Set: The well point noted above was removed, and replaced with a 2" diameter, 30" long, PVC pipe with a base magnet and a standard brass Emmet County Survey Remonumentation Program Cap, which was placed within a standard monument box. This position is accepted as a careful and faithful perpetuation of the position of the original corner.

Additional New Witnesses:

- S 08° E, 27.75', fence corner
- S 43° E, 57.06', 6" red pine, tagged 33983, in the E face

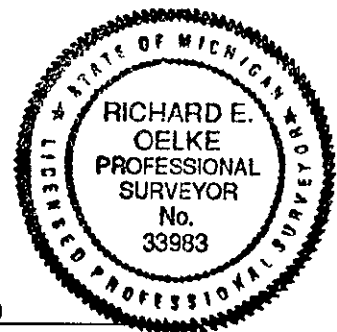

Signed by *R.E. Oelke* Date 10 December 1999
Surveyor's Michigan License No. 33983