

MAR 16 1994

LAND CORNER RECORDATION CERTIFICATE Filing Requirement of Act 74, Mich. P.A. 1970

1994 FEB 14 AM 10:14

For corners in EMMET (County) COMMISSION

Located In: READMOND TOWNSHIP Corner Code # I-11

Glenna B. Sizemore REGISTER OF DEEDS

- 1. Public Land Survey ECRP #27
2. Property Controlling in Section
3. Miscellaneous Property in Sec.

LIBER A PAGE 20

Register of Deeds Stamp & File Number

- 4. Lot No. Recorded Plat
5. Private Claims

Richard E. Oelke 30 December 93

I, do hereby certify that under requirements of P.A. 74, Michigan P.A. of 1970, the corner points mentioned in lines 1 and 2 above were in conformance with regulations and rules therefore as required in the current manual of survey instructions of the United States Department of the Interior, Bureau of Land Management or by a decree of a Court of Law and/or that the corner points mentioned in lines 3, 4 and 5 above were in conformance with the rules of the Michigan Board of Land Surveyors or by a Decree of a Court of Law; established, re-established, monumented, re-monumented, recovered, found as expressed below:

Grid table with columns A-M and rows 2-13. A dot is marked at the intersection of column J and row 11.

NOTE: Not more than 4 corners, all in the same town and range, may be recorded on this certificate.

A. Description of original monument and accessories and/or subsequent restoration:

- I-11, Section corner 26,27,34,35 T37N, R6W
-1840 GLO Set cedar post N52°E, 061ks, 15" beech & S66°W, 22 lks, 9" beech
-1900 Keep Liber 1, pages 22/23, Fd. stone, said to have been set from original bearing tree. Keep said he found pieces of iron around fd. stone 1 mile E., matches what we fd.
-1946 ECRC Map C(3J), Fd. 1/2" iron rod, 6" below ground. (1) N40°E, 53.6', 24" elm (2) S60°E, 92.2', cor. hse.; (3) S30°W, 74.6', 10" maple
-1972 Green LCRC, Liber 1, page 128, Fd. iron; (4) S38°W, 68.88', 12" maple (5) N73°E, 93.10', 20" elm
-1982 Walker Used "T-iron"
-1992 Oelke Used "T-iron"
-1992 Swenor Used "T-iron"
-1993 Trowbridge Used "T-iron" (6) N36°E, 75.30', power pole (7) N50°E, 100.45', power pole (8) S43°E, 40.20', cable marker (9) S53°W, 47.10', power pole

B. Description of corner evidence found and/or method applied in restoring or reestablishing corner:

I-11, Section corner 26,27,34,35 T37N, R6W

Found "T-iron" +/- 1.5' W. of CL State Rd. & +/- 4' S. CL Robinson Rd., flush with the surface. From 1' to 2' below the surface found assorted very old pieces of casted metal with a rotted 2"x2" post alongside. At 2' below surface began finding assorted pieces of broken glass, mason jars, mugs, and window paine to 2.5' below the surface.


- N31°E, 75.25', fd(6) power pole tagged #27463 in E face
N55°E, 100.46', fd(7) power pole with galvanized spike in N face
S47°E, 40.35', fd(8) center of underground cable post
S33°W, 68.83', fd(4) 12" maple with nail in NW face
S48°W, 47.05', fd(9) power pole tagged #27463 in N face

C. Description of monument for corner and accessories established to perpetuate locating the position of the corner:

I-11, Section corner 26,27,34,35 T37N, R6W

At found "T-iron", set a 2" diam., 30" long, PVC pipe with a base magnet and a standard brass Emmet County Survey Remonumentation Program cap in a monument box. This position is accepted as a careful and faithful perpetuation of the position of the original corner.

- N31°E, 75.25', fd(6) power pole tagged #27463 in E face
N55°E, 100.46', fd(7) power pole with galvanized spike in N face
S71°E, 138.16', 20" cottonwood tagged #33983 in N face
S47°E, 40.35', fd(8) center of underground cable post
S33°W, 68.83', fd(4) 12" maple with nail in NW face
S48°W, 47.05', fd(9) power pole tagged #27463 in N face
N47°W, 103.59', 4" red pine tagged #33983 in NE face

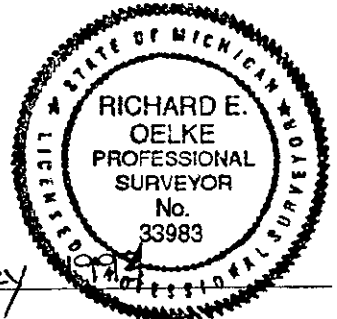

Signed by RICHARD E. OELKE Surveyor's Michigan License No. 33983

Date 12 JANUARY 1994