

SURVEY & REMONUMENTATION

MAR 04 1998

STATE OF MICHIGAN  
EMMET COUNTY  
RECORDED

SECTION

LAND CORNER RECORDATION CERTIFICATE 97 DEC 29 PM 3:10  
Filing Requirement of Act 74, Mich. P.A. 1970

For corners in

EMMET  
(County)

Located In:

Corner Code #

1. Public Land Survey

T 37N R 6W

K-6

ECRP #141

2. Property Controlling in Section

S \_\_\_ T \_\_\_ R \_\_\_

3. Miscellaneous Property in Sec.

S \_\_\_ T \_\_\_ R \_\_\_

4. Lot No. \_\_\_\_\_, Recorded Plat \_\_\_\_\_

5. Private Claims \_\_\_\_\_

*Alma L. Sizer*  
REGISTER OF DEEDS

LIBER A

PAGE 213

Register of Deeds Stamp & File Number

	A	B	C	D	E	F	G	H	I	J	K	L
2	6	5	4	3	2	1						
3												
4	7	8	9	10	11	12						
5												
6	18	17	16	15	14	13						
7												
8	19	20	21	22	23	24						
9												
10	30	29	28	27	26	25						
11												
12	31	32	33	34	35	36						
13												

I, Thomas D. Swenor in a field survey on 12/14, 1997, do hereby certify that under requirements of P.A. 74, Michigan P.A. of 1970, the corner points mentioned in lines 1 and 2 above were in conformance with regulations and rules therefore as required in the current manual of survey instructions of the United States Department of the Interior, Bureau of Land Management or by a decree of a Court of Law and/or that the corner points mentioned in lines 3, 4 and 5 above were in conformance with the rules of the Michigan Board of Land Surveyors or by a Decree of a Court of Law; established, re-established, monumented, re-monumented, recovered, found as expressed below:

NOTE: Not more than 4 corners, all in the same town and range, may be recorded on this certificate.

A. Description of original monument and accessories and/or subsequent restoration:

K-6, Quarter (1/4) Corner common to Sections 13, and 14, T37N R6W

SEE BACK PAGE OF THIS FORM FOR CHRONOLOGY

B. Description of corner evidence found and/or method applied in restoring or reestablishing corner:

K-6,  
Found T-Iron as set by J.H. Green (see L. 1, P.29, LCRC). T-Iron found at intersection of fence lines north and east, and centerline of Rugged Road (west). Corner is approximately 10 foot west of Rugged Road (south). This portion of Rugged Road is in a curve, and does not fall near the T-Iron. Found and verified the power pole witness, see (3) below.

THE T-IRON IS ACCEPTED BY THE EMMET COUNTY REMONUMENTATION PROGRAM AS A CAREFUL AND FAITHFUL PERPETUATION OF THE ORIGINAL CORNER.


APPROVED LAND CORNER  
P.A. 345 OF 1990  
Emmet County  
R.E. Devoe  
E.C.R.P. REP.  
12-30-97

C. Description of monument for corner and accessories established to perpetuate locating the position of the corner:

K-6,  
Found T-Iron as set by J.H. Green (see L. 1, P.29), and replaced with a 2" diameter, 30" long PVC Pipe with abase magnet and a standard brass Emmet County Remonumentation Cap.

Witnesses:

- (3) N51°E 71.06' - Power Pole (set spike nail with 37282 cap)
- (4) N78°W 33.44' - 12" Popular (set spike nail with 37282 cap)
- (5) N25°W 16.54' - 5" Popular (set spike nail with 37282 cap)
- (6) S61°E 74.52' - 4" Scotch Pine (set spike nail with 37282 cap)

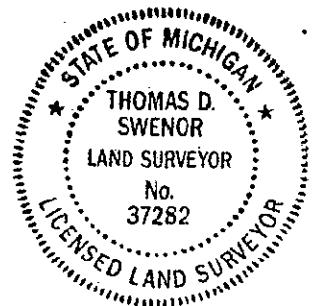

Signed by Thomas D. Swenor

Date 12/29/97

#141, 37-6 K-6

## A. DESCRIPTION OF ORIGINAL MONUMENT AND ACCESSORIES AND/OR SUBSEQUENT RESTORATION:

Date	Surveyor	Found	(Witnesses)
1840	GLO	Set QR. Sec. Post	(1) Sugar 25 S36W 12 (2) Hemlock 18 N34W 15
1972	J.H. Green	Set T-Iron (Liber 1, Page P.29-30, LCRC)	(3) N50E 70.90' - Power Pole (4) North 52.85' - 3rd fence post North of corner post.
1980	G.E. Young	Found T-Iron	no wit's.
1993	T.D. Swenor	Found T-Iron (Liber 498, Page 617, Rec. Survey)	(3) N50E 70.90' - Power Pole (4) North 52.85' - 3rd fence post
1993	T.D. Swenor	Found T-Iron	same as above.