

MICHIGAN
DEPARTMENT OF CONSERVATION
FORESTRY DIVISION

LAND CORNER RECORD

T. 38 N. R. 4 W.
T. 39 N. R. 4 W.


Emmet COUNTY

DESCRIPTION OF CORNER Section corner common to Sections 1 - 2 - 35 - 36

CORNER MONUMENT Set 1" pipe with 4" brass cap

DATE MONUMENT PLACED AND WITNESSED June 11, 1962

WITNESSES TO CORNER.....

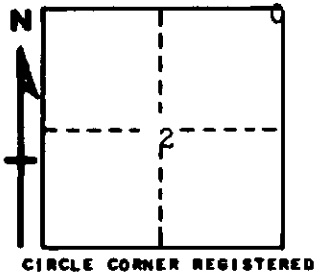

18" Spruce	S 45 E	37.6'
8" Cedar	S 60 W	85.9'
AND Road	North	30.0'

DESCRIPTION IN DETAIL AS TO HOW CORNER WAS LOCATED AND IDENTIFIED OR RESTORED.

This corner was established while making a survey in this area. Unable to locate any evidence of a previous corner. Set this corner on line between town corner east and reestablished 1/4 corner 1/2 mile west for latitude, at a distance therefrom equal to the measurement of the west 1/2 mile on north side of Section 2. This is in recognition of the original intent to place the 1/4 corner midway between section corners. This results in a fairly normal shaped Section 2 and conforms to measurements obtained on the south boundary of Section 2. This position conforms very nearly in longitude with evidences of old survey line blazes found along the line between Sections 1 - 2. A shortage in Section 1 is noted, but this is also evident in the south line of Section 1 between existing corners.

SURVEYOR'S SEAL

SIGNED *Kenneth J. Oetting* DATE June 14, 1962
REGISTERED LAND SURVEYOR