

MICHIGAN  
DEPARTMENT OF CONSERVATION  
FORESTRY DIVISION

# LAND CORNER RECORD

T. 38 N. R. 4 W.


Emmet COUNTY

DESCRIPTION OF CORNER 1/4 corner common to Sections 1 - 2

CORNER MONUMENT Set 1" pipe with 4" brass cap

DATE MONUMENT PLACED AND WITNESSED June 11, 1962

WITNESSES TO CORNER.....

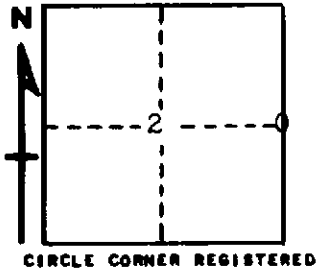

8" Cedar S 10 W 2.0'

8" Cedar S 84 E 9.5'

AND

**DESCRIPTION IN DETAIL AS TO HOW CORNER WAS LOCATED AND IDENTIFIED OR RESTORED.**

This corner was established by proportionate measurement between section corners north and south while making a survey in this area. No evidence of a previous corner. Some blazed trees in vicinity, but nothing conclusive.

**SURVEYOR'S SEAL**

SIGNED Kenneth J. Ostling DATE June 14, 1962  
REGISTERED LAND SURVEYOR