


**LAND CORNER RECORDATION CERTIFICATE**  
**Filing Requirement of Act 74, Mich. P.A. 1970**

For corners in  
**EMMET**

(County)	Located In:	Corner Code =#
1. Public Land Survey	T <u>38N</u> R <u>4W</u>	<u>B-3, C-1, C-3</u>
	T _____ R _____	_____
	T _____ R _____	_____
	T _____ R _____	_____
2. Property Controlling in Section	S _____ T _____ R _____	_____
	S _____ T _____ R _____	_____
3. Miscellaneous Property in Sec.	S _____ T _____ R _____	_____
	S _____ T _____ R _____	_____

Register of Deeds Stamp & File Number

4. Lot No. \_\_\_\_\_, Recorded Plat \_\_\_\_\_  
 5. Private Claims \_\_\_\_\_

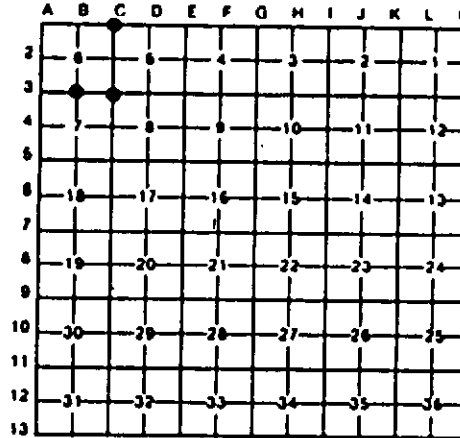

I, C.F. ROSER, in a field survey on DECEMBER, 09, 19 93, do hereby certify that under requirements of P.A. 74, Michigan P.A. of 1970, the corner points mentioned in lines 1 and 2 above were in conformance with regulations and rules therefore as required in the current manual of survey instructions of the United States Department of the Interior, Bureau of Land Management or by a decree of a Court of Law and/or that the corner points mentioned in lines 3, 4 and 5 above were in conformance with the rules of the Michigan Board of Land Surveyors or by a Decree of a Court of Law, established, re-established, monumented, re-monumented, recovered, found as expressed below:

**NOTE:** Not more than 4 corners, all in the same town and range, may be recorded on this certificate.

**A. Description of original monument and accessories and/or subsequent restoration:**

<u>B-3</u>	<u>C-1</u>	<u>C-3</u>
(NO EVIDENCE OF G.L.O. CORNER, AS CALLED OUT IN THE G.L.O. ITEM "B" BELOW.)	B.T.'S, LINE TREES & TOPOGRAPHY	LINE NOTES; UNLESS NOTED IN

\*B\* CONT.-- THIS COR IS SEC  
 COR COMM TO SEC'S 5 &  
 6, T38N-R4W AND SEC'S 31 &  
 32, T39N-R4W.

**B. Description of corner evidence found and/or method applied in restoring or reestablishing corner:**

<u>B-3</u>	<u>C-1</u>	<u>C-3</u>
FD 1/2" IR ROD W/RLS CAP BY JAMES BECK (PS021559), FOR S1/4 COR OF SEC 6. FITS PROP MEA TO G.L.O. (RUN OUT SEC). CTR OF E-W GRAVEL RD IS 6' SOUTH. FD FENCE REMAINS 5' LY (FOR 200') IS WOODS, WEST, 22'.	PRIOR DEPT CORNER OF RECORD. RLS, K. OSTLING, N. DEPT OF CONS, 1962 (FORERUNNER OF PRESENT DNR), FD IR & 4-WITS FROM 1928 RLS, F. SOLL SUR FOR WILDERNESS STATE PARK. OSTLING REPLACED SOLL IR W/CONS DEPT FORESTRY DIV 4" DIA BRONZE DISK ON 1" PIPE. COR FALLS IN LOWLAND HARDWOODS IN 3" OF WATER. APPROX CTR OF CECIL RD (C-NE & SW) IS 280' ± E. --CONT ABOVE--	FD 3/4" T IRON IN MON BOX IN CTR OF N-S B. TOP RD (CECIL BAY RD) AND IN LINE WITH CTR OF GRAVEL RD TO WEST (ELDER RD.) MON BOX HAD BEEN PATCHED OVER.

**C. Description of monument for corner and accessories established to perpetuate locating the position of the corner:**

<u>B-3</u>	<u>C-1</u>	<u>C-3</u>
FD 1/2" IRON ROD W/PS CAP & BENT 1/2" PIPE. SE COR LOG HOUSE, W/STONE FND.	FD CONS. DEPT. MON; DROVE STUDDED STEEL FM POST.	FD 3/4" T IRON IN MON BOX.
N25°W 75.3'	5" ASH N55°W 10.7'	N END 24" CMP N55°W 51.3'
039°W.PINE N10°E 23.15'	3" ASH N55°E 1.0'	4"x 5" TREATED TEL RISER POST. N65°E 40.00'
40°W.PINE S30°E 50.92'	4" ASH S20°E 9.0'	11" TW.CEDAR S35°W 74.32'
022°MAPLE S40°W 55.91'	3" ASH S35°W 7.9'	013" CEDAR S50°W 69.83'

# = HIT BY OTHERS.

# = HIT BY OTHERS.

Signed by Carl F. Roser 12-09-93 Date \_\_\_\_\_  
 Surveyor's Michigan License No. 12028

