

1994 JUN -8 PH 2:40

LAND CORNER RECORDATION CERTIFICATE  
Filing Requirement of Act 74, Mich. P.A. 1970

For corners in  
Emmet Co.  
(County)

Located In: Corner Code #


- |                                    |                          |            |
|------------------------------------|--------------------------|------------|
| 1. Public Land Survey              | T <u>38N</u> R <u>4W</u> | <u>C-2</u> |
|                                    | T _____ R _____          | _____      |
|                                    | T _____ R _____          | _____      |
|                                    | T _____ R _____          | _____      |
| 2. Property Controlling in Section | S _____ T _____ R _____  | _____      |
|                                    | S _____ T _____ R _____  | _____      |
| 3. Miscellaneous Property in Sec.  | S _____ T _____ R _____  | _____      |
|                                    | S _____ T _____ R _____  | _____      |

*Liliana L. Sipes*  
REGISTER OF DEEDS

LIBER 3  
PAGE 116

Register of Deeds Stamp & File Number

4. Lot No. \_\_\_\_\_, Recorded Plat \_\_\_\_\_
5. Private Claims \_\_\_\_\_

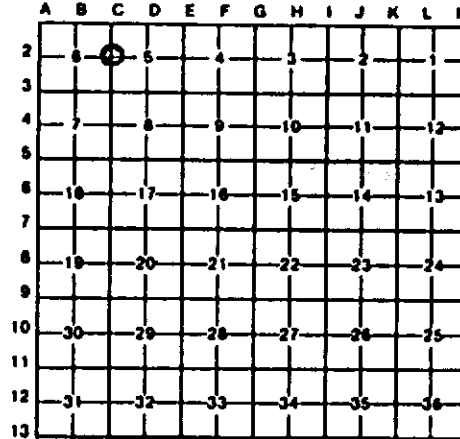

I, Carl F. Roser, in a field survey on 10-06-88 & 6-08-94, do hereby certify that under requirements of P.A. 74, Michigan P.A. of 1970, the corner points mentioned in lines 1 and 2 above were in conformance with regulations and rules therefore as required in the current manual of survey instructions of the United States Department of the Interior, Bureau of Land Management or by a decree of a Court of Law and/or that the corner points mentioned in lines 3, 4 and 5 above were in conformance with the rules of the Michigan Board of Land Surveyors or by a Decree of a Court of Law; established, re-established, monumented, re-monumented, recovered, found as expressed below:

NOTE: Not more than 4 corners, all in the same town and range, may be recorded on this certificate.

A. Description of original monument and accessories and/or subsequent restoration:  
No remaining evidence of G.L.O. "Calls" or B.T.'s

B. Description of corner evidence found and/or method applied in restoring or reestablishing corner:  
Re-estab. 1/4 Cor. Comm. to Sec's 5 & 6 at Prop. Mea. to U.S.; G.L.O. Sur. (Run-out Sec. between fd. Sec. Cor's to N. & S. and on line bet. said Sec. Cor's. Ctr. of N-S (B. Top) Co. Rd., Cecil Bay Rd., is 1.5' West. Nailed Conservation Dept. Alumin. Location Tag on W. Pine N.B.T. Our data from our re-estab. 1/4 Cor. (S.P. to U.S., Runout Sec. 15 = Sec. Cor. to South, 5 00° 07' 05" W, 2660.00' and Sec. Cor. to North, N 00° 07' 05" E, 2696.58'.  
Note: Fd. 5/8" rered w/RLS Cap #16051, North, 18.4'. This rod was set in error at M.O.L. between sec. Cor's to N. & S. Ref. Cert. of Survey, Liber 449, Pg. 382, dated 22 July 1991. Have been advised that this rered will be corrected.

C. Description of monument for corner and accessories established to perpetuate locating the position of the corner:

Drove 5/8" x 18" rered w/plastic RLS Cap #12028  
17" W. Pine N55°W 59.77 (side nail)  
Tele Pole 24" N80°E 58.72 (PK Nail-Side-flush)  
Top Ctr. 18" Conc. Culu. S65°W 44.2'  
Pipe ~ SOUTH END (top)  
Top Ctr. 24" Conc. Culu. West 38.6'  
Pipe ~ North END (top)  
ctr. ditch dirt drive to west 15 10' South.



Signed by Carl F. Roser Date 6-08-94  
Surveyor's Michigan License No. #12028