

MICHIGAN
DEPARTMENT OF CONSERVATION
FORESTRY DIVISION

LAND CORNER RECORD

T. 38 N.R. 5 W.


Emmet COUNTY

DESCRIPTION OF CORNER Meander Corner common to Sections 19-30 on west side
Wycamp Lake

CORNER MONUMENT 1" pipe with 4" brass cap

DATE MONUMENT PLACED AND WITNESSED May 18, 1961

WITNESSES TO CORNER.....

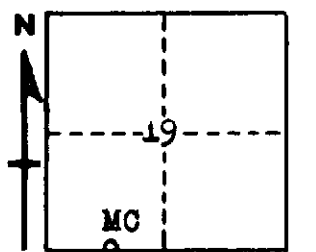

18" R. Pine - N34W - 62½ links

18" R. Pine - S75W - 109 links

AND

CIRCLE CORNER REGISTERED

DESCRIPTION IN DETAIL AS TO HOW CORNER WAS LOCATED AND IDENTIFIED OR RESTORED.

This corner was restored by Forestry Division survey crew while making a survey in this area. Set corner from probable NW gov't BT stump, which places corner at margin of lake and at record measurement from section corner on town line.

SURVEYOR'S SEAL

SIGNED *Kenneth J. Ostling* DATE 5/24/61
REGISTERED LAND SURVEYOR