

MICHIGAN
DEPARTMENT OF CONSERVATION
FORESTRY DIVISION

LAND CORNER RECORD

T. 38 N.R. 5W

Emmet COUNTY

DESCRIPTION OF CORNER Section corner common to sections 19, 20, 29, and 30

CORNER MONUMENT 1" pipe with 1/2" brass cap


DATE MONUMENT PLACED AND WITNESSED May 18, 1961

WITNESSES TO CORNER..... 5" Elm - N64E - 115 links

5" Elm - N25W - 60 1/8 links

8" Balsam - S51W - 103 1/2 links

AND

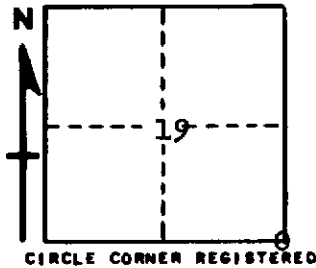

DESCRIPTION IN DETAIL AS TO HOW CORNER WAS LOCATED AND IDENTIFIED OR RESTORED.

This corner was restored by Forestry Division survey crew while making a survey in this area. Set corner by proportionate measurement between meander corner on West side of Wycamp Lake between 19 and 30 and section corner 1 mile east for longitudinal position. Used fence corner for latitude position since this conforms to centerline of road east and appears to have been considered acceptable as the section line. N - S proportion not justified because of gross inaccuracies of government survey.

SURVEYOR'S SEAL

SIGNED

Kenneth J. Ostling
REGISTERED LAND SURVEYOR

DATE May 25, 1961