

LAND CORNER RECORDATION CERTIFICATE
Filing Requirement of Act 74, Mich. P.A. 1970

For corners in
EMMET

(County)

Located In:

Corner Code *##*

1. Public Land Survey T 38N R 5W
 T _____ R _____
 T _____ R _____
 T _____ R _____

2. Property Controlling S _____ T _____ R _____
 in Section S _____ T _____ R _____

3. Miscellaneous S _____ T _____ R _____
 Property in Sec. S _____ T _____ R _____


Corner Code *##*

L-1, M-1

Register of Deeds Stamp & File Number

4. Lot No. _____, Recorded Plat _____

5. Private Claims _____

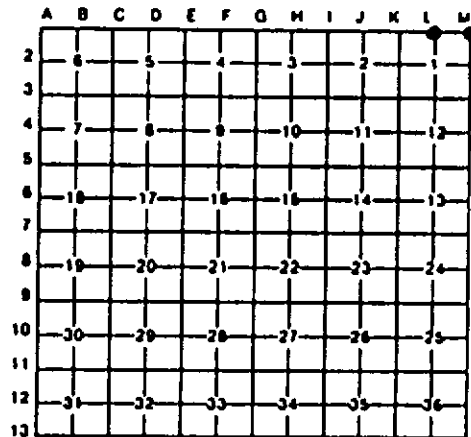

I, CARL F. ROSE, in a field survey on JUNE 8, 19 93, do hereby certify that under requirements of P.A. 74, Michigan P.A. of 1970, the corner points mentioned in lines 1 and 2 above were in conformance with regulations and rules therefore as required in the current manual of survey instructions of the United States Department of the Interior, Bureau of Land Management or by a decree of a Court of Law and/or that the corner points mentioned in lines 3, 4 and 5 above were in conformance with the rules of the Michigan Board of Land Surveyors or by a Decree of a Court of Law; established, re-established, monumented, re-monumented, recovered, found as expressed below:

NOTE: Not more than 4 corners, all in the same town and range, may be recorded on this certificate.

A. Description of original monument and accessories and/or subsequent restoration:

<p>L-1</p> <p>(NO EVIDENCE OF G.L.O. CORNER, B.T'S, LINE TREES & TOPOGRAPHY, AS CALLED OUT IN THE G.L.O. LINE NOTES; UNLESS NOTED IN ITEM "B" BELOW.)</p>	<p>M-1</p> <p>SHOWS ALL CORNS, WITS TO CORNS, COORDIN'S ON ALL CORNS AND BRG (BASED ON TRUE MERIDIAN) & DISTANCES BETW STD CORNS. IN BK 34, PG 111, SOLL "CALLED ON MR JOHN KINGOTT, RETIRED TRESPASS AGENT FOR ST OF MICH; 1905-09 & 1913-22". LIVES IN CAPAC MICH. KINGOTT SAID " HE KNOWS</p>	<p>M-1 CONT</p> <p>OF HIS MEN MAKE AN EXCAVATION SEARCH FOR GOV'T COR FOR THE 4 TWP COR ON SLIGHT RISE ABOVE SWP, SOME 39'M & B'E OF FD 4' SQ CONC MON (IN SWP). AS SET BY R.SAXTON IN 1922 (SEE E 1/4 COR S-1, 38N-5W, M-2). SOLL'S MEN FD A 2 1/2" X 11' CED STK ROTTED IN MIDDLE & POINTED</p>
---	--	---

B. Description of corner evidence found and/or method applied in restoring or reestablishing corner:

<p>L-1</p> <p>FD "T" RAIL FOR 1/4 COR COMM TO S-36 (39N-5W) & S-1 (38N-5W); AS SET (S.P.) BY RLS FRED SOLL IN 1920 RETRAC SUR OF T39N-R5W. FOR BACKGRD ON SOLL SUR SEE COR REC FOR NE COR OF S-1 (38N-5W), M-1. RLS JOHN FERGUSON USED THIS COR FOR SEC SUB'M (SEC 1, 38N-5W) IN 1979 & 1980. CTR OF OLD ABANDONED E-W TRAIL IS 31' SOUTH.</p>	<p>M-1</p> <p>FD NARROW GAUGE "T" RAIL (R.R. RAIL ON END) AS CALLED FOR BY SOLL SUR 1920 (4.3' LONG) FOR FOUR TWP CORNS. COMM TO T38&39N-R4&5W. REG SURV'R FRED J.M. SOLL, IN SUMMER OF 1920, DID A COMPLETE RETRACE SUR OF T39N-R5W, FOR WILDERNESS ST PARK. WE (DNR) POSSESS HIS FIELD NOTES; HARDBOUND FIELD BOOKS, NO'S 31, 34 & 36 AND HIS LG SUR MAP (SCALE: 1" = 400')</p>	<p>M-1 CONT</p> <p>T39N-R5W QUITE WELL AS HIS HD HAD BEEN AT CARP LK", AND SAID "HE ALWAYS TOOK THE SE COR OF TWP TO BE AT STK IN SWP JUST S OF LOW RIDGE". SIDNEY G MAIN OF BRUTUS SET STK (CO SUR SET IN CASES OF DISPUTE). SOLL ALSO MET W/FRANK CASSIDY (BK 34, PG 115) AT HIS HOME IN S-14 T38N-R5W ON 7/18/1920. CASSIDY WAS 61 YRS OLD & HAD BEEN IN THIS COUNTRY SINCE</p>	<p>M-1 CONT</p> <p>ON BOTTOM. THE TOP OF CED STK ROTTED OFF AT GRD LEVEL. SOLL REEXAM HIS "FIND" OF JUNE 20; THE EXCAV. EXPANDED TO A TOTAL OF 11'E, 14'M, 11'S & 9'W OF FD OLD POINTED CED STK BOTTOM. NO OTHER EVID OF COR FD. SOLL ACCEPTED 4 TWP COR AT OLD CED STK BOTTOM ON BASIS OF CASSIDY TESTIMONY PLUS HIS ORIG SEARCH AREA BASED ON SUR RETRACE LINES 1.8 MILES W, 1 MILE E,</p>
--	---	--	--

C. Description of monument for corner and accessories established to perpetuate locating the position of the corner:

<p>L-1</p> <p>FD "T" RAIL; ADDED CEDAR POST. 9" CEDAR N70°E 3.4' 18" CEDAR S70°E 8.5' 19" CEDAR S10°E 21.4' 11" CEDAR S20°N 16.0'</p>	<p>M-1</p> <p>FD "T" RAIL 4' ABOVE GRD; ADDED CED POST W/LOC TAG. 7" MAPLE N70°W 54.8' 6" W BIRCH S60°E 37.2' 15" CEDAR S10°E 24.5' 8" SPRUCE S50°W 18.7' FD 4"x4" CONC MON W/ 1/2" IR RD S11°W 39.4'</p>	<p>M-1 CONT</p> <p>1880, HAD BEEN BUSY ALL HIS LIFE IN TIMBER, AT TASKS OF MANY KINDS & HAS KNOWN PRACTICALLY ALL OF THE SEC CORNS IN T39N-R5W. "AS TO THE TOWN COR OF T38&39N - R4&5W, HE REMEMBERS THAT IT STOOD ON A SLIGHT RAISE AND NOT IN SWP; THAT WAS 20 - 25 YEARS AGO." ON 6/28/1920, SOLL HAD TWO</p>	<p>M-1 CONT</p> <p>4.2 MILES W & 1 MILE S; AND SET "T" RAIL. SAXTON CONC MON WAS PLACED AT POSITION OF FD CED STK IN SWP. (THERE WERE SEVERAL OF THEM.) THE FD "T" RAIL (4 TWP COR) FALLS ON N'LY END OF SMALL RIDGE (C-W & SE); THE RIDGE BEING 3' TO 4' ABOVE CEDAR AND BALSAM SWP.</p>
---	---	--	---

* RLS, J.FERGUSON MIT.

Signed by Carl F. Rose 12-09-93 Date _____

Surveyor's Michigan License No. 12028

