LAND CORNER RECORDATION CERTIFICATE

Filing Requirement of Act 74, Mich. P.A. 1970

For corners in
EMMET
(County)

Located in: Corner Code =

1. Public Land Survey — T 38N R5W — G-1, H-1
   T ____ R ____ — I-1
   T ____ R ____
   T ____ R ____
2. Property Controlling — S ____ T ____ R ____
   In Section — S ____ T ____ R ____
3. Miscellaneous — S ____ T ____ R ____
   Property in Sec. — S ____ T ____ R ____

Register of Deeds Stamp & File Number

4. Lot No. _____ , Recorded Plat _____
5. Private Claims _____

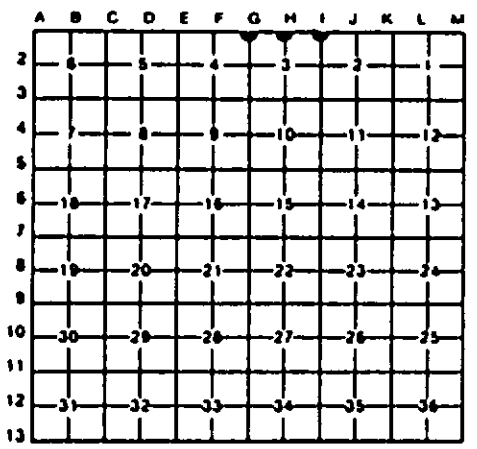

I, CARL F. ROSER, in a field survey on APRIL 19, 19 93, do hereby certify that under requirements of P.A. 74, Michigan P.A. of 1970, the corner points mentioned in lines 1 and 2 above were in conformance with regulations and rules therefore as required in the current manual of survey instructions of the United States Department of the Interior, Bureau of Land Management or by a decree of a Court of Law and/or that the corner points mentioned in lines 3, 4 and 5 above were in conformance with the rules of the Michigan Board of Land Surveyors or by a Decree of a Court of Law; established, re-established, monumented, re-monumented, recovered, found as expressed below:

NOTE: Not more than 4 corners, all in the same town and range, may be recorded on this certificate.

A. Description of original monument and accessories and/or subsequent restoration:

G-1 — H-1 — I-1

(NO EVIDENCE OF G.L.O. CORNER, B.T'S, LINE TREES & TOPOGRAPHY, AS CALLED OUT IN THE G.L.O. LINE NOTES; UNLESS NOTED IN ITEM "B" BELOW.)

B. Description of corner evidence found and/or method applied in restoring or reestablishing corner:

G-1	H-1	I-1
RESTORED NW COR S-3 ON S LINE OF S-33, GLO DISTANCE W OF SE COR S-33.	ESTABLISHED N 1/4 COR S-3, MIDWAY BETWEEN NE & NW S-3 AND ON LINE BETWEEN FOUND S 1/4 COR & SW COR OF S-34,T39N-R5W. CTR OF TRAIL ENE & WSW IS 21' NORTH.	RESTORED NE COR OF S-3 (CLOSING COR) AT RECORD GLO DISTANCE WEST OF STD COR (SE S-34) AND ON LINE BETWEEN FOUND SE & S 1/4 COR OF S-34 (39N-5W). CTR OF E-W TRAIL IS 32' NORTH.

C. Description of monument for corner and accessories established to perpetuate locating the position of the corner:

G-1	H-1	I-1
DR 1"X 46" GALV PIPE W/ALUM DNR CAP; SET CEDAR POST.	SET DNR MON & CED POST.	PUSHED IN 1"X 60" GALV PIPE W/ ALUM DNR CAP. SET CEDAR POST.
12" HEMLOCK S40°E 19.5'	3" W PINE S65°E 16.7'	5" TAMARACK S20°E 17.1'
4" MAPLE S30°W 19.4'	3" W PINE S15°E 36.4'	4" CEDAR S20°W 7.9'
9" HEMLOCK S60°W 14.4'	6" W PINE S50°W 7.0'	4" CEDAR S65°W 12.5'
DNR MON SW COR S-34, T39N-R5W N89°48'E 9.9'	DNR MON S 1/4 COR SEC 34, T39N-R5W N89°09'E 25.61'	DNR MON, SEC COR TO 34 & 35, T29N-R5W N88°48'E 9.90'

STATE OF MICHIGAN — CARL F. ROSER — LAND SURVEYOR — No. 12028 — REGISTERED LAND SURVEYOR

Signed by Carl F. Roser 12028 — Date 12-07-93

Surveyor's Michigan License No. _____

FORM APPROVED BY MICHIGAN STATE BOARD OF LAND SURVEYORS, JAN. 28, 1971
REVISED MAY 14, 1975
REVISED JAN. 1983