LAND CORNER RECORDATION CERTIFICATE

Filing Requirement of Act 74, Mich. P.A. 1970

For corners in
EMMET
(County)

Located in:

Corner Code #

1. Public Land Survey		T 38N R 5W	G-2
		T ___ R ___	
		T ___ R ___	
		T ___ R ___	
2. Property Controlling in Section	S 3	T ___ R ___	10, 11
	S ___	T ___ R ___	
3. Miscellaneous Property in Sec.	S 3	T ___ R ___	1850' E OF CORE
	S ___	T ___ R ___	11, S-3.

Register of Deeds Stamp & File Number

4. Lot No. _____ , Recorded Plat _____
5. Private Claims _____

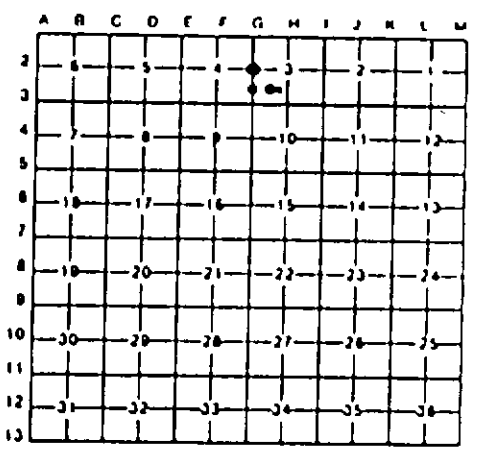

I, CARL F. ROSER, in a field survey on APRIL 19, 19 93, do hereby certify that under requirements of P.A. 74, Michigan P.A. of 1970, the corner points mentioned in lines 1 and 2 above were in conformance with regulations and rules therefore as required in the current manual of survey instructions of the United States Department of the Interior, Bureau of Land Management or by a decree of a Court of Law and/or that the corner points mentioned in lines 3, 4 and 5 above were in conformance with the rules of the Michigan Board of Land Surveyors or by a Decree of a Court of Law; established, re-established, monumented, re-monumented, recovered, found as expressed below:

NOTE: Not more than 4 corners, all in the same town and range, may be recorded on this certificate.

A. Description of original monument and accessories and/or subsequent restoration:

G-2	10	11	1
(NO EVIDENCE OF G.L.O. CORNER, B.T'S, LINE TREES & TOPOGRAPHY, AS CALLED OUT IN THE G.L.O. LINE NOTES; UNLESS NOTED IN ITEM "B" BELOW.)			

B. Description of corner evidence found and/or method applied in restoring or reestablishing corner:

G-2	10	11	1
REESTAB W 1/4 COR S-3 AT PROP MEA & STRAIGHT LINE TO GLO, BETWEEN NW & SW COR'S OF S-3 (RUN-OUT SEC).	ESTAB NW COR OF SW 1/4 OF SW 1/4 OF S-3 PER STD BLM INSTRUCTIONS FOR SEC SUB'N.	ESTABLISHED CENTER OF SW 1/4 OF S-3 PER STD. BLM INSTRUCTIONS FOR SECTION SUBN.	DROVE 5/8" X 34" REROD ON S LINE OF N 1/2 OF SW 1/4 OF S-3; 850' E OF CTR OF SW 1/4 OF S-3. WINDING TRAIL ROAD IS 108' N. O'NEAL LK IS 83' ± SOUTH & 50' ± EAST.

C. Description of monument for corner and accessories established to perpetuate locating the position of the corner:

G-2	10	11	1
DROVE 1" X 48" GALV PIPE W/ALUM DNR CAP; SET CED POST.	DROVE 5/8" X 34" REROD W/RLS CAP. SET CED POST W/LOC TAG.	DROVE 5/8" X 34" REROD W/LS CAP & SET CED POST W/LOC TAG.	DR 5/8" X 34" REROD W/RLS CAP; SET ROUND CED POST W/LOC TAG.
3" CEDAR N05°W 12.9'	7" W PINE N25°W 18.0'	12" CEDAR N40°E 14.0'	13" R PINE NORTH 18.2'
8" TN W PINE N45°E 32.2'	4" R PINE N30°E 21.4'	12" SPRUCE S35°E 3.8'	6" HEMLOCK N40°E 15.3'
4" CEDAR S60°E 11.7'	5" CEDAR S20°E 8.1'	10" CEDAR S55°W 18.6'	6" W PINE S50°W 13.5'
2" TAMARACK S10°W 13.7'	6" CEDAR S15°W 13.1'	CTR E-W TRAIL SOUTH 206' ±	4" W PINE S80°W 7.8'
6" CEDAR N55°W 15.9'	N-S RANDOM WEST 27'		CTR SW1/4 S-3 S86°19'W 850.0'
N-S RANDOM WEST 65'			

Signed by Carl F. Roser 12-09-93 Date _____

Surveyor's Michigan License No. 12028

STATE OF MICHIGAN
CARL F. ROSER
SURVEYOR
No. 12028
REGISTERED LAND SURVEYOR

FORM A ADVISORY BY MICHIGAN STATE BOARD OF LAND SURVEYORS JAN 28, 1971
REVISED MAY 14, 1975
REVISED JAN, 1983