


LAND CORNER RECORDATION CERTIFICATE
Filing Requirement of Act 74, Mich. P.A. 1970

For corners in
ENNET

(County)	Located In:	Corner Code <i>LL</i>
1. Public Land Survey	T <u>38N</u> R <u>5N</u>	<u>L-5, M-5</u>
	T _____ R _____	_____
	T _____ R _____	_____
	T _____ R _____	_____
2. Property Controlling in Section	S <u>12</u> T _____ R _____	<u>16</u>
	S _____ T _____ R _____	_____
3. Miscellaneous Property in Sec.	S _____ T _____ R _____	_____
	S _____ T _____ R _____	_____

Register of Deeds Stamp & File Number

4. Lot No. _____, Recorded Plat _____
 5. Private Claims _____

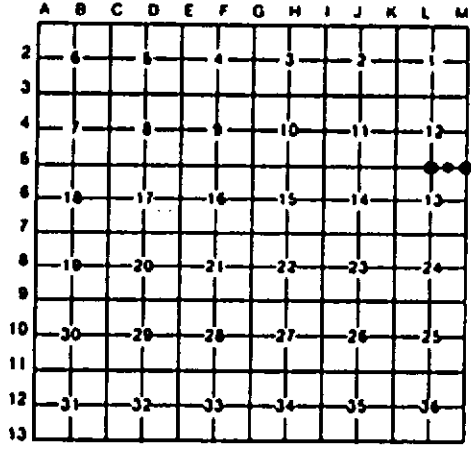

I, CARL F. ROSE, in a field survey on JULY 12, 19 93, do hereby certify that under requirements of P.A. 74, Michigan P.A. of 1970, the corner points mentioned in lines 1 and 2 above were in conformance with regulations and rules therefore as required in the current manual of survey instructions of the United States Department of the Interior, Bureau of Land Management or by a decree of a Court of Law and/or that the corner points mentioned in lines 3, 4 and 5 above were in conformance with the rules of the Michigan Board of Land Surveyors or by a Decree of a Court of Law; established, re-established, monumented, re-monumented, recovered, found as expressed below:

NOTE: Not more than 4 corners, all in the same town and range, may be recorded on this certificate.

A. Description of original monument and accessories and/or subsequent restoration:

L-5	M-5	M-5 CONTINUED	16
(NO EVIDENCE OF G.L.D. CORNER, B.T.'S, LINE TREES & TOPOGRAPHY, AS CALLED OUT IN THE G.L.D. LINE NOTES; UNLESS NOTED IN ITEM "B" BELOW.)		(CONTINUED FROM "B" BELOW)	
		RESTORED COR (DR 5/8" X 34" REROD) IS 0.4' E OF CTR OF X-CULV (CMP). CTR E-W B.TOP RD (IN FLAT CURVE) IS 1.3' S. FOR ADDL INFO ON SAXTON & SOLL SEE COR'S M-2 & M-3.	

B. Description of corner evidence found and/or method applied in restoring or reestablishing corner:

L-5	M-5	M-5 CONTINUED	16
RESTORED S 1/4 SEC 12 EQUIDISTANT & ON LINE BETW SEC COR'S 1/2 MILE TO E & W. CO. SUR, S.G. MAIN, 1893 SUR NOTES, INDICATE HE SET THIS COR AT S.P. POSITION. CTR E-W B.TOP RD IS 3' SOUTH FD PK. N86°06'E, 15.30'.	RESTORED SEC COR COMM TO S-12 & S-13 (T38N-R5N) & S-7 & S-18 (T38N-R4W) AT PROP MEA TO REN. G. SAXTON 1922 NEAR 1 MILE E & 1 MILE W AND ON LINE ACROSS FD 1/4 COR & SEC COR TO E, WHICH FITS 1960 RD COMM SUR OF BILL RD FOR 2 MILES (FROM CECIL RD W 2 MILES TO CO. CROSS RD). SAXTON NOTES BAY REPL FD SQ ADJ STKS W/A CONC POST (MON); 3' E OF CULV IN CTR OF RD. IN	1960 RD COMM SUR. NOTES SHOW THEY FD COR (NOT DESCRIBED) BUT APPARENTLY UNDER OR NEAR THE EXIST CONC CULV. SAID CONC CULV BEING REPL W/48" C.M.P. OUR RESTORED POS FITS SAXTON DIST 1 MILE N & 1/2 MILE S. ALSO FIT S.G.MAIN 1893 DIST 1 MILE W VERY CLOSE. TOP OF C.M.P. X-CULV IS 4'± BELOW B.TOP RD SURFACE & (CONTINUED IN "A" ABOVE)	ESTAB SE COR OF SW 1/4 OF SE 1/4 OF S-12. EQUIDISTANT & ON LINE BETW SEC COR EAST & 1/4 COR WEST. COR FALLS 1' SOUTH OF CTR OF E-W B.TOP ROAD.

C. Description of monument for corner and accessories established to perpetuate locating the position of the corner:

L-5	M-5	M-5 CONTINUED	16
DR 5/8" X 34" REROD W/RLS CAP.	DR 5/8" X 34" REROD W/RLS CAP.		DR 5/8" X 34" REROD W/RLS CAP.
9° CEDAR N30°W 41.5'	8° CEDAR N50°W 49.0'		10° CEDAR N30°W 37.0'
9° CEDAR N20°E 54.4'	3° CEDAR S25°E 43.2'		9° CEDAR N20°E 39.6'
7° CEDAR S25°E 48.5'	FD 2" GALV PIPE S30°W 48.4'		6° CEDAR S35°E 64.0'
8° CEDAR S 3°W 66.5'	N END CMP DUE N 28.6'		9° TAMARACK S20°W 44.0'
SET CED POST W/ LOC TAG. NORTH 33'	S END CMP DUE S 28.0'		SET CEDAR POST WITH LOC TAG. NORTH 27'
	FD 3/4" PIPE N89°45'E 9.92'		
	FD 3/4" RD IR N89°20'W 24.00'		

Signed by Carl F. Roser 12-09-93
 Surveyor's Michigan License No. 12028

Date _____