


LAND CORNER RECORDATION CERTIFICATE
Filing Requirement of Act 74, Mich. P.A. 1970

For corners in
EMMET

(County)	Located In:	Corner Code -//
1. Public Land Survey	T <u>38N</u> R <u>5W</u>	<u>M-6, M-7</u>
	T _____ R _____	_____
	T _____ R _____	_____
	T _____ R _____	_____
2. Property Controlling in Section	S <u>13</u> T _____ R _____	<u>13, 14</u>
	S _____ T _____ R _____	_____
3. Miscellaneous Property in Sec.	S _____ T _____ R _____	_____
	S _____ T _____ R _____	_____

Register of Deeds Stamp & File Number

4. Lot No. _____, Recorded Plat _____
 5. Private Claims _____

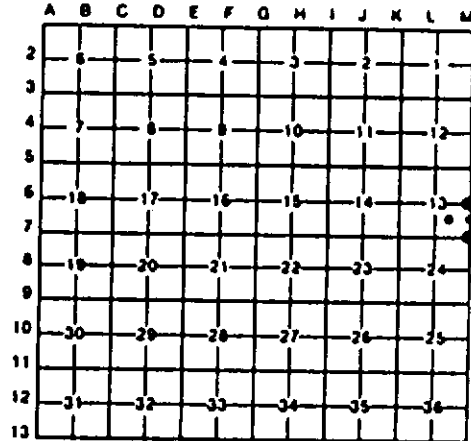

I, CARL F. ROGER, in a field survey on JULY 19, 19 93, do hereby certify that under requirements of P.A. 74, Michigan P.A. of 1970, the corner points mentioned in lines 1 and 2 above were in conformance with regulations and rules therefore as required in the current manual of survey instructions of the United States Department of the Interior, Bureau of Land Management or by a decree of a Court of Law and/or that the corner points mentioned in lines 3, 4 and 5 above were in conformance with the rules of the Michigan Board of Land Surveyors or by a Decree of a Court of Law; established, re-established, monumented, re-monumented, recovered, found as expressed below:

NOTE: Not more than 4 corners, all in the same town and range, may be recorded on this certificate.

A. Description of original monument and accessories and/or subsequent restoration:

M-6	M-7	13	14
-----	-----	----	----

(NO EVIDENCE OF G.L.O. CORNER, D.T.'S, LINE TREES & TOPOGRAPHY, AS CALLED OUT IN THE G.L.O. LINE NOTES; UNLESS NOTED IN ITEM "B" BELOW.)

("B" CONTINUED)
 CTR OF GRAVEL RD (LOOKING MNW)
 IS 33' ± WEST.

B. Description of corner evidence found and/or method applied in restoring or reestablishing corner:

M-6	M-7	13	14
FD 4" SQ CONC MON FOR 1/4 COR COMM TO S-13 (38N-RW) & SEC 18 (38N-R4W). FITS TWO 1922 SAXTON WITS. SEE SUR OF TWP LINE COMM TO T38N-R4 & 5W BY R.G. SAXTON; NOTES AT BLISS TWP. HALL AS OF 10/12/89. FD 1/2" X 18" REROD, N88°15'E, 38.46'	FD & ACCEPTED 5/8" X 27" PIPE; W/BROKEN SQ CONC MON ALONGSIDE SAME, FOR COR COMM TO SEC'S 13 & 24 (38N-5W) & SEC'S 18 & 19 (38N-4W). COR FITS ONE 1922 WIT REMAINS (26" ELM STP REMAINS, N85W, 98.4') FROM 1922 SUR OF T38N-R4 & 5W BY REN G. SAXTON. NOTES AT BLISS TWP HALL AS OF 10/12/92. COR IS IN LINE WITH CTR OF GRAVEL RD LOOKING E. (CONTINUED IN "A")	ESTAB SW COR OF NE 1/4 OF SE 1/4 (CTR OF SE 1/4) OF S-13 PER STD BLM INSTRUCTIONS. COR FALLS IN CTR OF LOGGING TRAIL (SELDOM USED) S'LY TO HILLS. CTR OF GRAVEL CO ROAD (CURVING) IS 166' NORTH.	ESTAB SE COR OF NE 1/4 OF SE 1/4 OF S-13 PER STD BLM INSTRUCTIONS. COR FALLS IN E'LY EDGE OF 4' ROUND BOTTOM (N-S) DITCH. CTR OF OLD N-S 5' ROUND BOTTOM DITCH IS 54' EAST. NO EVIDENCE OF N-S ROAD BETWEEN DITCHES.

C. Description of monument for corner and accessories established to perpetuate localing the position of the corner:

M-6	M-7	13	14
FD 4" X 4" CONC MON WITH 1/2" IR ROD; ADDED CED POST W/LOC TAG. 89° TW.ASH N30°W 7.1' 9° CEDAR N60°E 53.5' 814° TW W BIRCH N75°E 14.1' 6° CEDAR S40°E 43.7' 9° CEDAR S27°W 57.4'	FD 5/8" X 27" PIPE & BROKEN 4" X 4" CONC. 22" SUG.MAPLE N30°E 66.66' 18" SUG.MAPLE S50°E 36.76' 8" ROUND TREATED COR FN POST SOUTH 15.55' 12" ASH S60°W 45.03' CTR RD (IN CURVE) N35°E 35' FN COR (FN'S E & S) SOUTH 15'	DROVE 5/8" X 34" REROD W/RLS CAP & SET CED POST W/LOC TAG. 7" SUG.MAPLE N80°W 35.5' 5" SUG.MAPLE N30°W 21.8' 8" SUG.MAPLE N70°E 35.0' 12" SUG.MAPLE S10°E 39.7'	DROVE 5/8" X 34" REROD W/RLS CAP & SET CED POST W/LOC TAG. 6" APPLE TREE N10°W 22.3' 17° TW.CEDAR S75°E 66.7' 3" ELM S40°E 6.2' 5" W.BIRCH S30°W 27.3'

WIT BY OTHERS.

Signed by Carl F. Roger 12-07-93 Date _____
 Surveyor's Michigan License No. 12028



BOARD OF LAND SURVEYORS, JAN. 28, 1971
 REVISED MAY 14, 1975
 REVISED JAN., 1983