LAND CORNER RECORDATION CERTIFICATE

Filing Requirement of Act 74, Mich. P.A. 1970

For corners in EMMET (County)

	Located in:	Corner Code ##
1. Public Land Survey	T 38N R 5W	E-7, F-7
	T ___ R ___	G-6, G-7
	T ___ R ___	
	T ___ R ___	
2. Property Controlling	S ___ T ___ R ___	
in Section	S ___ T ___ R ___	
3. Miscellaneous	S ___ T ___ R ___	
Property in Sec.	S ___ T ___ R ___	

Register of Deeds Stamp & File Number

4. Lot No. _____ , Recorded Plat _____
5. Private Claims _____

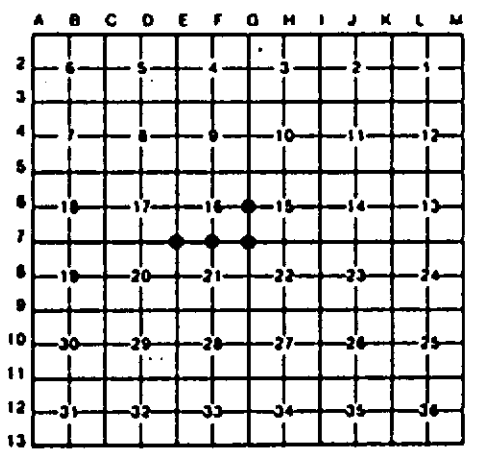

G-7

I, CARL F. ROSER, in a field survey on APRIL 20, 19 93, do hereby certify that under requirements of P.A. 74, Michigan P.A. of 1970, the corner points mentioned in lines 1 and 2 above were in conformance with regulations and rules therefore as required in the current manual of survey instructions of the United States Department of the Interior, Bureau of Land Management or by a decree of a Court of Law and/or that the corner points mentioned in lines 3, 4 and 5 above were in conformance with the rules of the Michigan Board of Land Surveyors or by a Decree of a Court of Law; established, re-established, monumented, re-monumented, recovered, found as expressed below:

NOTE: Not more than 4 corners, all in the same town and range, may be recorded on this certificate.

A. Description of original monument and accessories and/or subsequent restoration:

E-7 F-7 G-6 G-7

(NO EVIDENCE OF G.L.O. CORNER, B.T'S, LINE TREES & TOPOGRAPHY, AS CALLED OUT IN THE G.L.O. LINE NOTES; UNLESS NOTED IN ITEM "B" BELOW.)

B. Description of corner evidence found and/or method applied in restoring or reestablishing corner:

E-7
COR FITS CO SURVEYOR, M. PALMER SURVEY OF S-16 IN 1901. HIS NOTES ON RECORD AT REG OF DEEDS INDICATE NO GOVT CORNER FOUND, SET CED POST 7".

F-7
ACCEPTED FD 3/4" IR ROD FOR 1/4 COR COMM TO SEC'S 16 & 21. COR FITS M.O.L. POSITION REAL CLOSE. CO SURVEYOR M. PALMER, IN SEC 16 IN 1901 AND SEC 21 IN 1902, INDICATED HE REESTAB THIS 1/4 S.P. (NOTES AT REG DEEDS). COR IS IN LINE WITH OLD FN TO NORTH. ±3'). CAN SEE 2 POSTS STANDING TO NORTH.

G-6
FD 1/2" REROD BY RLS MIKE TRONBRIDGE. ACCEPTED FOR 1/4 COR COMM TO SEC'S 15 & 16. FITS SUR & SEC SUB'N OF S-15 (ALSO 1911 NBT) BY CO SURVEYOR S.G. MAIN (SET S.P.), JULY 1911; ON RECORD AT REG OF DEEDS.

G-7
FD 3/4" "T" IR (FLUSH) IN CTR OF RD INTERSEC ± 1'. (BIT SURFACE RD E.W.S & DIRT RD N). FITS 1911 CO SURVEYOR S.G. MAIN SUR OF S-15 & WIT. (SW COR OF CHURCH WALL, PRIOR TO PRESENT ADDITION, N40°E, 76.8'); SGM SAYS "POST FD IN HWY HAS BEEN KEPT FROM GOVT COR". ALSO COR FITS CO RD COMM WIT & J.H. GRANGER WIT.

C. Description of monument for corner and accessories established to perpetuate locating the position of the corner:

E-7
FD 3/4" ROUND IRON IN NON BOX.

*PK IN WOOD FLAG		
POLE BASE	N62°W	96.44'
POWER POLE	N40°E	83.68'
*22" MAPLE	S35°W	62.47'
GUY POLE	S60°W	63.17'

*CO. RD COMM WIT.

F-7
FD 3/4" IRON ROD IN APPROX CTR OF E-W CO RD (B-TOP).

*POWER POLE	S05°E	51.40'
S END 18" CMP		
CROSS CULVERT	S40°W	32.8'
N END 18" CMP		
CROSS CULVERT	N50°W	29.8'
BURIED TELE CABLE		
SIGN POST	N40°W	32.8'

*=CO RD COMM WIT.

G-6
FD 1/2" REROD W/RLS CAP. COR IS BURIED (12") ON E EDGE N-S DIRT ROAD.

*10" SUG MAPLE	N25°W	68.37'
*RR TIE COR FN POST	S89°E	34.97'
*CED FN POST	S30°E	63.28'
12" SUG MAPLE	S70°W	57.55'

*RLS #27463 (M.T.) WIT.

G-7
FD 3/4" "T" IRON.

*SW COR CHURCH FOUNDATION	N45°E	69.6'
POWER POLE	S60°W	84.40'
*GUY POLE	N50°W	48.18'

*RLS MIKE TRONBRIDGE WIT.

Signed by Carl F. Roser Date 12-09-93

Surveyor's Michigan License No. 12028

STATE OF MICHIGAN — CARL F. ROSER — LAND SURVEYOR No. 12028 — REGISTERED LAND SURVEYOR

WORD APPROVED BY THE MICHIGAN STATE BOARD OF LAND SURVEYORS, JAN. 20, 1971
REVISED MAY 14, 1975
REVISED JAN., 1983