# LAND CORNER RECORDATION CERTIFICATE

**Filing Requirement of Act 74, Mich. P.A. 1970**

For corners in
EMMET
(County)

| | Located In: | Corner Code ## |
|---|---|---|
| 1. Public Land Survey | T 38N R 5W | D-5, D-6, |
| | T ____ R ____ | D-7, E-6 |
| | T ____ R ____ | |
| | T ____ R ____ | |
| 2. Property Controlling | S ____ T ____ R ____ | |
| in Section | S ____ T ____ R ____ | |
| 3. Miscellaneous | S ____ T ____ R ____ | |
| Property in Sec. | S ____ T ____ R ____ | |

Register of Deeds Stamp & File Number

4. Lot No. _____ , Recorded Plat _____
5. Private Claims _____

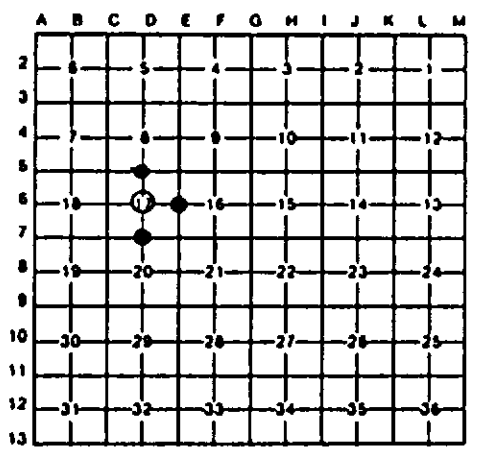


I, CARL F. ROSER, in a field survey on JUNE 5, 19 93, do hereby certify that under requirements of P.A. 74, Michigan P.A. of 1970, the corner points mentioned in lines 1 and 2 above were in conformance with regulations and rules therefore as required in the current manual of survey instructions of the United States Department of the Interior, Bureau of Land Management or by a decree of a Court of Law and/or that the corner points mentioned in lines 3, 4 and 5 above were in conformance with the rules of the Michigan Board of Land Surveyors or by a Decree of a Court of Law; established, re-established, monumented, re-monumented, recovered, found as expressed below:

**NOTE: Not more than 4 corners, all in the same town and range, may be recorded on this certificate.**

A. Description of original monument and accessories and/or subsequent restoration:

D-5 D-6 D-7 E-6

(NO EVIDENCE OF G.L.O. CORNER, B.T'S, LINE TREES & TOPOGRAPHY. AS CALLED OUT IN THE G.L.O. LINE NOTES; UNLESS NOTED IN ITEM "B" BELOW.)

B. Description of corner evidence found and/or method applied in restoring or reestablishing corner:

D-5
REESTAB 1/4 COR COMM TO SEC'S 8 & 17, MIDWAY & ON LINE BETW SEC COR'S TO E & W. E-W TRAVERSE LINE IS 53' SOUTH. N-S, B-W FN ON CED POSTS (MOSTLY DOWN) IS 31' ± WEST.

D-6
ESTAB CTR OF S-17 AT INTERSEC OF ONE QUARTER LINES. CTR OF E-W GRAVEL CO RD (ENDS IN MOBILE HOME YARD TO WEST) IS 15' SOUTH. CTR OF OLD (MANY POSTS. NOT STANDING) E-W FN TO WEST, LOOKING W'LY IS 4' SOUTH. OLD N-S FN TO NORTH AND NEWER N-S FENCE TO SOUTH ARE 11' WEST.

D-7
FD 1/2 REROD FOR 1/4 COR COMM TO SEC'S 17 & 20. OLD E-W R/W FN IS 33' ± NORTH. CTR E-W BIT SURFACE RD IS 1' NORTH. FD OLD 1" PIPE, N03°E, 37.0'. FD 1" PIPE (LEANING) 21.5' ± SOUTH. COR FITS M.O.L. REAL CLOSE; CO SURVEYOR M. PALMER, 1905, INDICATES HE SET 1/4 COR S.P. (SEC 20 NOTES AT REG DEEDS).

E-6
RESTORED 1/4 COR COMM TO SEC'S 16 & 17, M.O.L. BETW SEC COR'S TO N & S. COR FALLS IN CTR OF N-S BIT SURFACE RD AND IS ON SPLIT OF E-W R/W FN'S TO WEST (FN'S 51' APART). COR FALLS IN APPROX CTR OF DIRT ROAD, LOOKING TO WEST. CO SURVEYOR M. PALMER, 1901, INDICATES HE REESTAB THIS 1/4 COR S.P. IN SUR OF S-16 (NOTES AT REG OF DEEDS).

C. Description of monument for corner and accessories established to perpetuate locating the position of the corner:

D-5
SET DNR MON & CED POST.

| | | |
|---|---|---|
| 5" TW W BIRCH | N40°W | 12.9' |
| 4" CEDAR | N 5°W | 38.9' |
| 11" MAPLE (CLP3) | N75°E | 25.8' |
| 6" MAPLE | S40°E | 24.2' |

D-6
DROVE 5/8" X 34" REROD W/RLS CAP.

| | | |
|---|---|---|
| 8" W BIRCH | N50°W | 54.29' |
| 36" TW SUG MAPL | N 5°E | 21.39' |
| POWER POLE | S 5°W | 39.25' |
| 3" APPLE TREE | S25°W | 71.2' |

D-7
FD 1/2" REROD.

| | | |
|---|---|---|
| *20" MAPLE | N60°W | 61.50' |
| * 9" TW CEDAR | N20°W | 34.35' |
| 7" CEDAR | N30°E | 38.38' |
| 2" W PINE | S10°E | 34.31' |

E-6
DROVE 5/8" X 17" REROD W/RLS CAP.

| | | |
|---|---|---|
| 7" R PINE | N40°W | 67.74' |
| 4"X6"175" TALL POST W/ TEL CO BOX | N65°E | 38.82' |
| POWER POLE | S35°E | 67.58' |
| 4" MAPLE | S50°W | 57.77' |

*CO RD COMM WIT

Signed by Carl F. Roser 12-09-93 Date

Surveyor's Michigan License No. 12028

STATE OF MICHIGAN
CARL F. ROSER
LAND SURVEYOR
No. 12028
REGISTERED LAND SURVEYOR

FORM APPROVED BY MICHIGAN STATE BOARD OF LAND SURVEYORS, JAN 28, 1971
REVISED MAY 14, 1975
REVISED JAN, 1983