

LAND CORNER RECORDATION CERTIFICATE
Filing Requirement of Act 74, Mich. P.A. 1970

For corners in
EMMET
(County)

Located In: _____ Corner Code =# _____


- | | | | | | |
|------------------------------------|---|------------|---|-----------|------------------------------|
| 1. Public Land Survey | T | <u>38N</u> | R | <u>5W</u> | <u>B-6, C-5</u> |
| | T | _____ | R | _____ | _____ |
| | T | _____ | R | _____ | _____ |
| | T | _____ | R | _____ | _____ |
| 2. Property Controlling in Section | S | <u>7</u> | T | _____ | <u>16</u> |
| | S | _____ | T | _____ | _____ |
| 3. Miscellaneous Property in Sec. | S | <u>18</u> | T | _____ | <u>USMC, 2548' N OF C-5.</u> |
| | S | _____ | T | _____ | _____ |

Register of Deeds Stamp & File Number

4. Lot No. _____, Recorded Plat _____
5. Private Claims _____

I, CARL F. ROSE, in a field survey on JUNE 5, 19 93 do hereby certify that under requirements of P.A. 74, Michigan P.A. of 1970, the corner points mentioned in lines 1 and 2 above were in conformance with regulations and rules therefor as required in the current manual of survey instructions of the United States Department of the Interior, Bureau of Land Management or by a decree of a Court of Law and/or that the corner points mentioned in lines 3, 4 and 5 above were in conformance with the rules of the Michigan Board of Land Surveyors or by a Decree of a Court of Law; established, re-established, monumented, re-monumented, recovered, found as expressed below:

NOTE: Not more than 4 corners, all in the same town and range, may be recorded on this certificate.

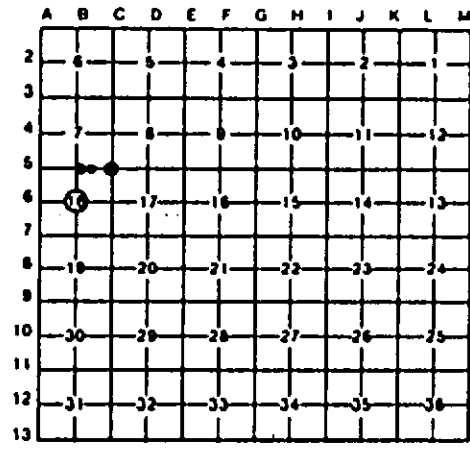

(°C CONTINUED)
MC ON N-S 1/4 LINE, DROVE 1" x 60° PIPE S17°53'N 334.3' EDGE WATER (L. MICH OCT 1990) NEST 115' ±

A. Description of original monument and accessories and/or subsequent restoration:

B-6 C-5 16
(NO EVIDENCE OF G.L.D. CORNER, D.T.'S, LINE TREES & TOPOGRAPHY, AS CALLED OUT IN THE G.L.D. LINE NOTES; UNLESS NOTED IN ITEM "B" BELOW.)

B. Description of corner evidence found and/or method applied in restoring or reestablishing corner:

<u>B-6</u> FB BIDSTRUP (RLS 811360) CTR OF FRL SEC 18, EXACT, PER OUR COMP'S FOR CTR OF B-18. SEE BIDSTRUP CERT SURVEY, LIBER 275, PG. 644. DATED APR. 27, 1977. BIDSTRUP FB THIS CTR OF B-18 IN JULY 1968.	<u>C-5</u> RESTORED NE COR OF S-18 PER RLS RICHARD BIDSTRUP CERT SUR. LIBER 275, PG. 644 (APR 1977). BIDSTRUP HAD DISTANCE FROM NE COR OF B-17 TO USMC ON SEC LINE COMM TO FRL. SEC'S 7 & 18. RESTORED SEC COR AT PROP MEASURE BETWEEN ABOVE CONTROL.	<u>16</u> ESTAB SW COR OF GOVT LOT 1 (SW COR OF FRL E 1/2 OF FRL S-7) AT PROP MEA TO G.L.D. BETWEEN SE COR OF S-7 AND U.S.M.C. ON SOUTH LINE S-7.	<u>6</u> RESTORED U.S.M.C. ON SEC LINE COMM TO FRL SEC'S 7 & 18 PER BIDSTRUP CERT SUR OF FRL SEC 18, LIBER 275, PG. 644. SUR DATED APR 27, 1977. DIST FROM NE COR OF FRL S-18 TO USMC EQUALS 2548.04' THIS SURVEY (810-1840 EQUALS 38.60 CH'S OR 2547.6').
---	---	---	---

C. Description of monument for corner and accessories established to perpetuate locating the position of the corner:

<u>B-6</u> FD 5/8" REROD W/RLS CAP; ADDED 1" X 96° GALV PIPE W/RLS CAP. DROVE STEEL FN POST. 11" W PINE N46°N 50.3' 10" W PINE N10°E 43.5' 9" R PINE N80°E 56.7' FB CONC NON ON RIDGE S89°51'E 170.9' FB CONC NON N89°51'W 275.0'	<u>C-5</u> SET DNR NON & CED POST. 8" R DAK N45°N 11.5' 5" SUB MAPLE N20°E 17.5' 7" HEMLOCK S25°E 7.4' 4" SUB MAPLE S45°N 18.0'	<u>16</u> DROVE 5/8" X 3/4" REROD W/RLS CAP. SET CED POST W/LDC TAG. 2" W PINE N30°N 16.1' 17" R PINE N25°E 20.5' 3" R DAK N80°E 11.4' 3" SUB MAPLE S65°W 15.1' CTR BIT RD DUE W 309' ± 6'	<u>6</u> DR 1" X 96° GALV PIPE W/ALUM DNR CAP & DROVE STL FN POST. NE COR S-18 N89°47'17"E 2548.04' 9" CED (CLP4) N60°E 27.1' 10" CEDAR S60°E 44.3' 14" R PINE S35°E 60.4'
---	---	---	---

(CONTINUED IN "A")

Signed by Carl F. Roser 12-09-93
Surveyor's Michigan License No. 12028

