

MICHIGAN  
DEPARTMENT OF CONSERVATION  
FORESTRY DIVISION

# LAND CORNER RECORD

T. 39 N.R. 4 W.


Emmet COUNTY

DESCRIPTION OF CORNER Section corner common to Sections 13 - 14 - 23 - 24

CORNER MONUMENT Left 1/2" iron bar in place in road intersection

DATE MONUMENT PLACED AND WITNESSED May 8, 1964

WITNESSES TO CORNER.....

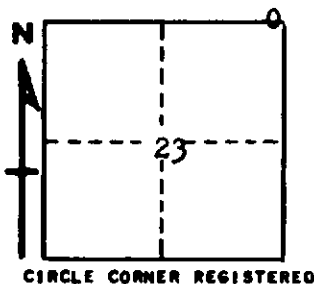

4" H. Maple N 49 W 66.6'

4" H. Maple S 68 W 56.4'

AND

DESCRIPTION IN DETAIL AS TO HOW CORNER WAS LOCATED AND IDENTIFIED OR RESTORED.

This corner was found while making a survey in this area. Found 1/2" iron rod in place in center of road intersection, apparently used in other surveys in this area. Best available evidence.

SURVEYOR'S SEAL

SIGNED Kenneth Postling DATE June 26, 1964  
REGISTERED LAND SURVEYOR #10068