

MICHIGAN  
DEPARTMENT OF CONSERVATION  
FORESTRY DIVISION

LAND CORNER RECORD

T. 39 N. R. 4 W


EMMET COUNTY

DESCRIPTION OF CORNER MEANDER CORNER COMMON TO SECTIONS 27 - 34 on WEST SIDE FRENCH LAKE

CORNER MONUMENT SET 1" PIPE WITH 4" ALUMINUM CAP

DATE MONUMENT PLACED AND WITNESSED APRIL 2, 1965

WITNESSES TO CORNER.....

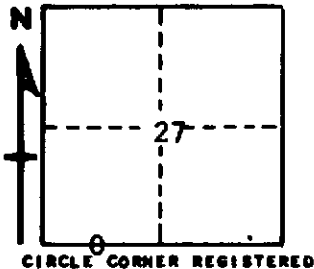

6" R. PINE S50W 34.6

16" R. PINE N51E 22.1

AND

DESCRIPTION IN DETAIL AS TO HOW CORNER WAS LOCATED AND IDENTIFIED OR RESTORED.

THIS CORNER WAS ESTABLISHED WHILE MAKING A SURVEY IN THIS TOWNSHIP. SET  
CORNER ON TRUE SECTION LINE AT SHORE OF LAKE.

SURVEYOR'S SEAL

SIGNED Kenneth Ostling DATE JUNE 4, 1965  
REGISTERED LAND SURVEYOR #19068