

MICHIGAN
DEPARTMENT OF CONSERVATION
FORESTRY DIVISION

LAND CORNER RECORD

T. 39 N. R. 4W


EMMET COUNTY

DESCRIPTION OF CORNER 1/2 CORNER COMMON TO SECTIONS 26 - 35

CORNER MONUMENT SET 1" PIPE WITH 4" ALUMINUM CAP

DATE MONUMENT PLACED AND WITNESSED MARCH 12, 1965

WITNESSES TO CORNER.....

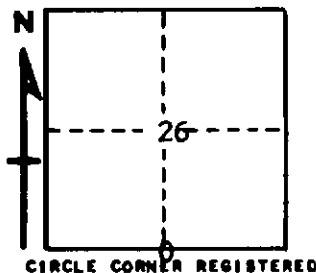

5" CEDAR N45W 6.0'

7" CEDAR S10E 8.7'

AND

DESCRIPTION IN DETAIL AS TO HOW CORNER WAS LOCATED AND IDENTIFIED OR RESTORED.

This corner was set midpoint on line between restored corner east and theoretical location for section corner west. No evidence of original corner or any restored corner.

SURVEYOR'S SEAL

SIGNED *Kenneth J. Ostling* DATE JUNE 3, 1965
REGISTERED LAND SURVEYOR # 10068