LAND CORNER RECORDATION CERTIFICATE

Filing Requirement of Act 74, Mich. P.A. 1970

For corners in EMMET (County)

Located In: | Corner Code :44

1. Public Land Survey — T 39N R 5W — E-13
2. Property Controlling in Section — S ____ T ____ R ____
3. Miscellaneous Property in Sec. — S 32 T ____ R ____ — #USMC 864'N OF E-13.

Register of Deeds Stamp & File Number

4. Lot No. _____ , Recorded Plat _____
5. Private Claims _____

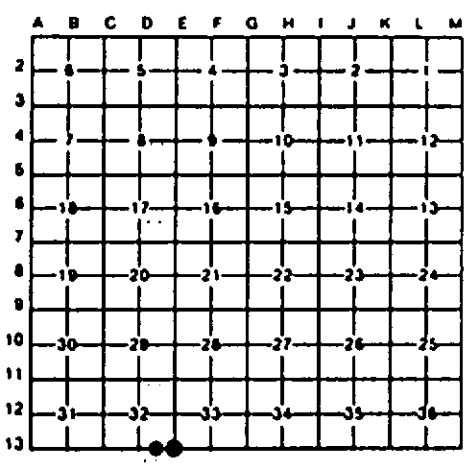

I, CARL F. ROSER, in a field survey on APRIL 19, 19 93, do hereby certify that under requirements of P.A. 74, Michigan P.A. of 1970, the corner points mentioned in lines 1 and 2 above were in conformance with regulations and rules therefore as required in the current manual of survey instructions of the United States Department of the Interior, Bureau of Land Management or by a decree of a Court of Law and/or that the corner points mentioned in lines 3, 4 and 5 above were in conformance with the rules of the Michigan Board of Land Surveyors or by a Decree of a Court of Law; established, re-established, monumented, re-monumented, recovered, found as expressed below:

NOTE: Not more than 4 corners, all in the same town and range, may be recorded on this certificate.

A. Description of original monument and accessories and/or subsequent restoration:

E-13 — # USMC — # (CONTINUED)

(NO EVIDENCE OF G.L.O. CORNER, B.T'S, LINE TREES AND TOPOGRAPHY, AS CALLED OUT IN THE G.L.O. LINE NOTES: UNLESS NOTED IN ITEM "B" BELOW.)

B. Description of corner evidence found and/or method applied in restoring or reestablishing corner:

E-13

FD 1" PIPE W/COUPLING AS SET IN 1928 BY F. SOLL FOR COR COMM TO SEC'S 32 & 33 (39N-5W) AND 4 & 5 (38N-5W); SOLL FD 5" SQ'D STK WHICH FIT ONE GLO BT (STUMP). NE FD CED POST POINT (PROBABLY REMAINS OF WHAT SOLL FD) AND USBT STUMP REMAINS. RLS FRED SOLL MADE COMPLETE RETRACEMENT SUR OF T39N-R5W, SUMMER 1928.

USMC

FD F. SOLL RR RAIL (VERTICAL) SET FROM 2 USBT (STUMPS) FOR U.S. MEANDER CORNER ON TWP LINE, T38 & 39N-R5W. RLS FRED SOLL MADE COMPLETE RETRACEMENT SURVEY OF T39N-R5W, SUMMER 1928.

(CONTINUED)

C. Description of monument for corner and accessories established to perpetuate locating the position of the corner:

E-13

FD 1" PIPE W/COUPLING; ADDED DNR ALUM CAP & SET CED POST.

#16" R PINE	N42°E	26.7'
#21" W PINE	N89°E	51.7'
#22" B OAK	S75°E	27.7'
#20" W PINE	N74°W	54.2'
16" R PINE	S20°E	5.4'

#F. SOLL 1928 WIT.

USMC

FD 0.15' X 0.18' X0.09' BY 3.25' LONG RAIL, 18" LONG PIECE OF LOGGING CHAIN & COIL OF WIRE; ADDED 1" X 60" GALV PIPE W/ALUM DNR CAP. SET CED POST.

#12" W PINE	N30°E	121.0'
#12" W PINE	N67°E	83.8'
#14" W PINE	S86°E	74.2'

(CONTINUED)

(CONTINUED)

#16" W PINE	S63°E	91.5'
15" R PINE	S60°E	64.7'
(WATER'S EDGE L.MICH) 10/8/90	WEST	410'±

#F. SOLL 1928 WIT.

STATE OF MICHIGAN — CARL F. ROSER LAND SURVEYOR No. 12028 — REGISTERED LAND SURVEYOR

Signed by Carl F. Roser 12-03-93 Date _____

Surveyor's Michigan License No. 12028

FORM APPROVED BY MICHIGAN STATE BOARD OF LAND SURVEYORS, JAN. 28, 1971
REVISED MAY 14, 1975
REVISED JAN. 1983