LAND CORNER RECORDATION CERTIFICATE

Filing Requirement of Act 74, Mich. P.A. 1970

For corners in
EMMET
(County)

	Located In:	Corner Code #/
1. Public Land Survey	T 39N R 5W	G-13, H-13,
	T ____ R ____	I-13
	T ____ R ____	
	T ____ R ____	
2. Property Controlling	S ____ T ____ R ____	
in Section	S ____ T ____ R ____	
3. Miscellaneous	S ____ T ____ R ____	
Property in Sec.	S ____ T ____ R ____	

Register of Deeds Stamp & File Number

4. Lot No. _____ , Recorded Plat _____
5. Private Claims _____

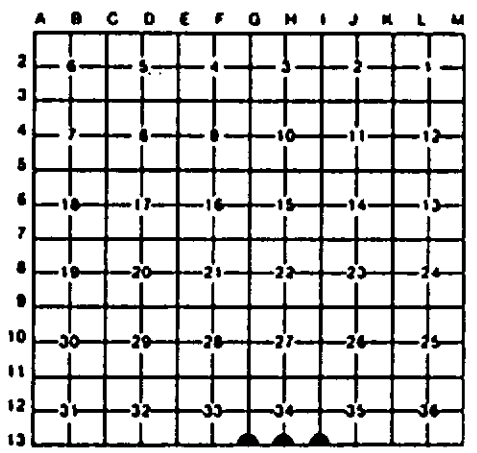

I, CARL F. ROSER , in a field survey on APRIL 19, , 19 93 , do hereby certify that under requirements of P.A. 74, Michigan P.A. of 1970, the corner points mentioned in lines 1 and 2 above were in conformance with regulations and rules therefore as required in the current manual of survey instructions of the United States Department of the Interior, Bureau of Land Management or by a decree of a Court of Law and/or that the corner points mentioned in lines 3, 4 and 5 above were in conformance with the rules of the Michigan Board of Land Surveyors or by a Decree of a Court of Law; established, re-established, monumented, re-monumented, recovered, found as expressed below:

NOTE: Not more than 4 corners, all in the same town and range, may be recorded on this certificate.

A. Description of original monument and accessories and/or subsequent restoration:

G-13 H-13 I-13

(NO EVIDENCE OF G.L.O. CORNER. B.T'S. LINE TREES AND TOPOGRAPHY, AS CALLED OUT IN THE G.L.O. LINE NOTES; UNLESS NOTED IN ITEM "B" BELOW.)

B. Description of corner evidence found and/or method applied in restoring or reestablishing corner:

G-13
ACCEPTED FD 1" PIPE FOR SW COR SEC 34. FRED SOLL, 1928, FD OLD CEDAR STK & STP OF GLO B.T. (CUT ABOVE BLAZES) W/OLD SCRIBE MARKS. FRED SOLL, RLS, MADE COMPLETE RETRACEMENT SUR OF T39N-R5W, SUMMER 1928.

H-13
FD 1" PIPE AS SET BY RLS, FRED SOLL IN 1928; FOR G 1/4 COR OF S-34; IN HOLLOW OF 36" W.PINE STUMP (SOLL FD STUMP W/ SQ'D CED STK IN SAME.) GLO CALLED FOR 36" PINE FOR S 1/4 COR OF SEC. 34. FD PIPE FITS ONE REMAINING SOLL WBT. CTR OF TRAIL ENE & WSW IS 24' NORTH. FRED SOLL, RLS, MADE COMPLETE RETRACEMENT SUR OF T39N-R5W. SUMMER 1928.

I-13
FD 4" SQ'D STK (LYING IN MUCK), AS FD BY F. SOLL IN 1928 FOR CORNER COMM TO SEC'S 34 & 35 (39N-R5W); DUG IN MUCK & WATER & FD 18" ± STK BOTTOM WHICH FITS 4 SOLL WBT'S (STUMPS). FRED SOLL, RLS, MADE COMPLETE RETRACEMENT SUR OF T39N-R5W, SUMMER 1928. CTR OF E-W TRAIL IS 32' NORTH.

C. Description of monument for corner and accessories established to perpetuate locating the position of the corner:

G-13
FD 1" PIPE. ADDED ALUM DNR CAP & SET CED POST.

*26" W PINE	N30°W	24.5'
15" R PINE	N 5°E	61.1'
2" R PINE	N70°E	12.7'
*25" W PINE	N80°E	26.8'

DNR MON NW COR G-3.
T38N-R5W S89°48'W 9.90'

*F. SOLL 1928 WIT.

H-13
FD 1" PIPE; ADDED ALUM DNR CAP & SET CED POST.

*35" W PINE	N45°W	90.7'
3" R PINE	N25°E	7.3'
15" MAPLE	N45°E	19.6'

DNR MON. N1/4 COR SEC3
T38N-R5W S89°09'W 25.61

*F. SOLL 1928 WIT.

I-13
FD CED POST POINT; PUSHED IN 1" X 96" GALV PIPE W/ALUM DNR CAP & SET CED POST.

3" CEDAR	N45°W	6.9'
17" CEDAR	N10°E	40.7'
6" TAMARACK	EAST	4.0'

DNR MON. SEC COR TO 2 & 3
T38N-R5W S88°48'W 9.90'

STATE OF MICHIGAN
CARL F. ROSER
LAND SURVEYOR
No. 12028
REGISTERED LAND SURVEYOR

Signed by Carl F. Roser 12-09-93 Date _____

Surveyor's Michigan License No. 12028

FORM APPROVED BY MICHIGAN STATE BOARD OF LAND SURVEYORS, JAN. 20, 1971
REVISED MAY 14, 1975
REVISED JAN., 1983