

**SURVEY & REMONUMENTATION**

APR 27 1995

**COMMISSION**

For corners in

GENESEE

(County)

Located In:

ARGENTINE TOWNSHIP

Corner Code #1

- |                                    |                         |            |
|------------------------------------|-------------------------|------------|
| 1. Public Land Survey              | T <u>5N</u> R <u>5E</u> | <u>A-3</u> |
|                                    | T _____ R _____         | _____      |
|                                    | T _____ R _____         | _____      |
|                                    | T _____ R _____         | _____      |
| 2. Property Controlling In Section | S _____ T _____ R _____ | _____      |
|                                    | S _____ T _____ R _____ | _____      |
| 3. Miscellaneous Property in Sec.  | S _____ T _____ R _____ | _____      |
|                                    | S _____ T _____ R _____ | _____      |

DEED LIBER 2565 PAGE 890

1994 REMONUMENTATION PROGRAM  
LAND CORNER RECORDATION CERTIFICATE  
Filing Requirement of Act 74, Mich. P.A. 1970

RECORDED  
FEB 16 7 38 AM '95  
REGISTERED  
7800  
Register of Deeds Stamp & File Number

4. Lot No. \_\_\_\_\_, Recorded Plat \_\_\_\_\_  
5. Private Claims \_\_\_\_\_

I, RICHARD H. KRAFT, in a field survey on OCTOBER 10, 19 94 do hereby certify that under requirements of P.A. 74, Michigan P.A. of 1970, the corner points mentioned in lines 1 and 2 above were in conformance with regulations and rules therefore as required in the current manual of survey instructions of the United States Department of the Interior, Bureau of Land Management or by a decree of a Court of Law and/or that the corner points mentioned in lines 3, 4 and 5 above were in conformance with the rules of the Michigan Board of Land Surveyors or by a Decree of a Court of Law; established, re-established, monumented, re-monumented, recovered, found as expressed below:

NOTE: Not more than 4 corners, all in the same town and range, may be recorded on this certificate.

A	B	C	D	E	F	G	H	I	J	K	L	M
2	6	5	4	3	2	1						
3												
4	7	8	9	10	11	12						
5												
6	18	17	16	15	14	13						
7												
8	19	20	21	22	23	24						
9												
10	30	29	28	27	26	25						
11												
12	31	32	33	34	35	36						
13												

A. Description of original monument and accessories and/or subsequent restoration:

- 1823/GLO - HARVEY PARKE, D.S. SET POST, NO ACCESSORIES
- 1892/ROAD DEEDS- CLARENCE TOWER & B. VASS RIPER, FOUND STONE & TILE, SET 2 ACCESSORIES
- 1921/G.C.R.C. - FOUND BRICK & STONE - SET IRON PIN, SET 3 ACCESSORIES
- 1981/SHELDON BROWN, RLS-FOUND 5/8" ROD, SET 3 ACCESSORIES, UNRECORDED SURVEY

B. Description of corner evidence found and/or method applied in restoring or reestablishing corner:

- 1994 REMONUMENTATION - RICHARD H. KRAFT, P.S. FOUND 1 INCH SQUARE BAR
- 1981/SURVEY BY SHELDON BROWN
  - EAST -FENCE POST - 34.86' (MEASURED 35.00 FT.)
  - N45°E - 40" OAK - 34.14' (FOUND 34.10 FT.)
  - S30°E - 12" MAPLE- 40.00' (FOUND 40.05')

Ratified by Peer Group in accordance with P.A. 345, 1990

co. Richard H. Carlson  
Date 12-21-94


RATIFIED BY GENESEE COUNTY PEER GROUP, DECEMBER 21, 1994.

C. Description of monument for corner and accessories established to perpetuate locating the position of the corner:

A-3 - SET STANDARD GENESEE COUNTY MONUMENT BOX AND GENESEE COUNTY MONUMENT

WITNESSES:

- N60°E, SET PK NAIL & G.C. TAG - 36" OAK, 31.55'
- N85°E, SET PK NAIL & G.C. TAG IN NW FACE POWER POLE, 31.8'
- S70°E, NW FACE SIGN POST, 20.95'
- N60°W, SET PK NAIL & G.C. TAG - 8" PINE, 41.35'

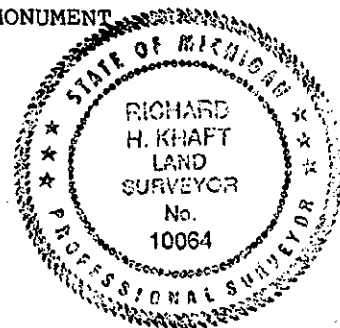

Signed by

Richard H. Kraft  
RICHARD H. KRAFT

Date

DECEMBER 31, 1994

Surveyor's Michigan License No.

10064