

# SURVEY & REMONUMENTATION

1994 REMONUMENTATION PROGRAM

DEED LIBER 2565 PAGE 892

APR 27 1995

## LAND CORNER RECORDATION CERTIFICATE

Filing Requirement of Act 74, Mich. P.A. 1970

For corners in

GENESEE COMMISSION

Located In:

Corner Code =#

(County)

ARGENTINE TOWNSHIP

1. Public Land Survey

T 5N R 5E

C-3

T R

T R

T R

T R

2. Property Controlling in Section

S T R

S T R

3. Miscellaneous Property in Sec.

S T R

S T R

4. Lot No. , Recorded Plat

5. Private Claims

RECORDED  
FEB 16 7 38 AM '95  
REGISTERED  
Register of Deeds Stamp & File Number

A	B	C	D	E	F	G	H	I	J	K	L	M
2	6	5	4	3	2	1						
3												
4	7	8	9	10	11	12						
5												
6	16	17	18	19	20	21	22	23	24			
7												
8	19	20	21	22	23	24						
9												
10	30	29	28	27	26	25						
11												
12	31	32	33	34	35	36						
13												

I, RICHARD H. KRAFT PS, in a field survey on, OCTOBER 10, 1994, do hereby certify that under requirements of P.A. 74, Michigan P.A. of 1970, the corner points mentioned in lines 1 and 2 above were in conformance with regulations and rules therefore as required in the current manual of survey instructions of the United States Department of the Interior, Bureau of Land Management or by a decree of a Court of Law and/or that the corner points mentioned in lines 3, 4 and 5 above were in conformance with the rules of the Michigan Board of Land Surveyors or by a Decree of a Court of Law; established, re-established, monumented, re-monumented, recovered, found as expressed below:

NOTE: Not more than 4 corners, all in the same town and range, may be recorded on this certificate.

A. Description of original monument and accessories and/or subsequent restoration:

- 1823/GLO- HARVEY PARKE, DS, SET POST, NO ACCESSORIES
- 1921/G.C.R.C. - FOUND STONE - SET IRON PIN, SET 4 ACCESSORIES
- 1972, ELBEX HARRIS, RLS - FOUND STONE, SET SQUARE IRON PIN, 4 ACCESSORIES, RECORDED IN LIBER 1821, PAGE 55.
- 1979/R.H. KRAFT, RLS - FOUND 1" X 3/4" SOLID IRON BAR, SET 3 ACCESSORIES
- 1993/M.VAN RAEMDONCK, RLS - FOUND 1" SQUARE BAR, RECORDED 4 ACCESSORIES, LIBER 2520, PG. 359

B. Description of corner evidence found and/or method applied in restoring or reestablishing corner:

- 1993/RAY PHILLIPS, RLS - FOUND 1" SQUARE BAR, SET 4 ACCESSORIES
- 1993/MARK VAN RAEMDONCK  
 S85°E, FACE 2" STEEL POST, 24.03' MEASURED 23.99'  
 S30°W, NAIL & TAG IN 24" ELM, 38.85' MEASURED 38.7'

RATIFIED BY GENESEE COUNTY PEER GROUP, DECEMBER 21, 1994


Ratified by Peer Group in accordance with P.A. 345, 1990

Co. Richard H. Kraft

Date 12-21-94

C. Description of monument for corner and accessories established to perpetuate locating the position of the corner:  
 1994/R. KRAFT, RLS - FOUND 1" IRON SQUARE ROD

- C-3: SET STANDARD GENESEE CO. MONUMENT AND MONUMENT BOX
- EAST - 3" STEEL FENCE CORNER POST, 23.99'
- N45°E, SET PK & GC TAG IN POWER POLE, 56.0'
- N70°E, FOUND DELTA TAG & NAIL IN 24" OAK, 31.33'
- S45°W, FOUND DELTA TAG & NAIL IN 24" BUTTERNUT, 38.54'
- N70°W, SET PK & GC TAG IN POWER POLE, 30.0'
- S45°W, FOUND LANDMARK NAIL & TAG IN 24" BUTTERNUT, 38.7'

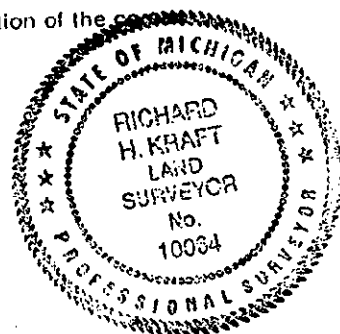

Signed by Richard H. Kraft

Date DECEMBER 21, 1994

Surveyor's Michigan License No. 10064