

SURVEY & REMONUMENTATION

DEED LIBER 2565 PAGE 893

APR 27 1995

1994 REMONUMENTATION PROGRAM
LAND CORNER RECORDATION CERTIFICATE
 Filing Requirement of Act 74, Mich. P.A. 1970

COMMISSION

For corners in
GENESEE

(County)	Located In:	Corner Code #
	ARGENTINE TOWNSHIP	
1. Public Land Survey	T 5N R 5E	D-3
	T _____ R _____	_____
	T _____ R _____	_____
	T _____ R _____	_____
2. Property Controlling in Section	S _____ T _____ R _____	_____
	S _____ T _____ R _____	_____
3. Miscellaneous Property in Sec.	S _____ T _____ R _____	_____

RECORDED
 FEB 16 7 30 AM '95
 REGISTERED
 7803
 Register of Deeds Stamp & File Number

1. Lot No. _____, Recorded Plat _____
 2. Private Claims _____

RICHARD H. KRAFT PS, in a field survey on OCTOBER 10, 19 94
 to hereby certify that under requirements of P.A. 74, Michigan P.A. of 1970, the corner points mentioned in lines 1 and 2 above were in conformance with regulations and rules therefore as required in the current manual of survey instructions of the United States Department of the Interior, Bureau of Land Management or by a decree of a Court of Law and/or that the corner points mentioned in lines 3, 4 and 5 above were in conformance with the rules of the Michigan Board of Land Surveyors or by a Decree of a Court of Law; established, re-established, monumented, re-monumented, recovered, found as expressed below:

	A	B	C	D	E	F	G	H	I	J	K	L	M
2	6	5	4	3	2								
3													
4	7	8	9	10	11	12							
5													
6	18	17	16	15	14	13							
7													
8	19	20	21	22	23	24							
9													
10	30	29	28	27	26	25							
11													
12	31	32	33	34	35	36							
13													

NOTE: Not more than 4 corners, all in the same town and range, may be recorded on this certificate.

- 1. Description of original monument and accessories and/or subsequent restoration:
 1823/GLO, HARVEY PARKE, DS- SET POST, NO ACCESSORIES
 1921/G.C.R.C., FOUND STONE-BRICK (PLACED STAKE) SET 4 ACCESSORIES
 1990/MARK VANRAEMDONCK, RLS, FOUND 3/4" PIN IN MON. BOX, SET 4 ACCESSORIES, RECORDED LIBER 2396, PAGE 974
 1993/MARK VANRAEMDONCK, RLS, FOUND IRON IN MONUMENT BOX, RECORDED 4 ACCESSORIES LIBER 2520, PAGE 359

3. Description of corner evidence found and/or method applied in restoring or reestablishing corner:

RICHARD H. KRAFT, 1994 - FOUND 1" IRON IN MONUMENT BOX
 1993/MARK VANRAEMDONCK, RLS
 N60°E, TOP CENTER RIGHT OF WAY MARKER, 59.71'
 S60°E, TOP CENTER RIGHT OF WAY MARKER, 60.00'


MEASURED
 59.7'
 59.3'

RATIFIED BY GENESEE COUNTY PEER GROUP, DECEMBER 21, 1994

Ratified by Peer Group in accordance with P.A. 345, 1990
 Co. Rep. Paul D. Carlson
 Date 12-21-94

C. Description of monument for corner and accessories established to perpetuate locating the position of the corner:

- D-3. SET STANDARD GENESEE COUNTY MONUMENT IN MONUMENT BOX
 N75°E, ROAD SIGN, 52.95'
 S45°E, NW CORNER R/W MARKER, 59.7'
 S80°E, SET PK & GC TAG IN 16" ASH, 108.9'
 N85°W, ARROW SIGN, N. LEG, 25.3'
 N60°E, TOP CENTER CONCRETE R/W MARKER, 59.7'

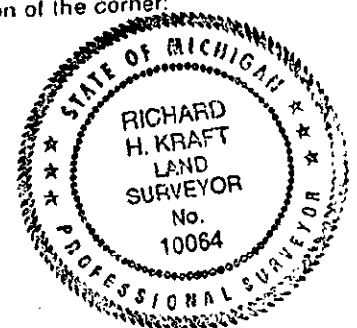

Signed by Richard H. Kraft Date DECEMBER 31, 1994
 Surveyor's Michigan License No. 10064