

SURVEY & REMONUMENTATION

DEED LIBER 2565 PAGE 894

APR 27 1995

1994 REMONUMENTATION PROGRAM
LAND CORNER RECORDATION CERTIFICATE
 Filing Requirement of Act 74, Mich. P.A. 1970

RECORDED
 FEB 16 7 30 AM '95
 7804
 Register of Deeds Stamp & File Number

For corners in **COMMISSION**
GENESEE
 (County)

Located In:

Corner Code #/

ARGENTINE TOWNSHIP

- | | | |
|------------------------------------|-------------------------|------------|
| 1. Public Land Survey | T <u>5N</u> R <u>5E</u> | <u>E-3</u> |
| | T _____ R _____ | _____ |
| | T _____ R _____ | _____ |
| | T _____ R _____ | _____ |
| 2. Property Controlling in Section | S _____ T _____ R _____ | _____ |
| | S _____ T _____ R _____ | _____ |
| 3. Miscellaneous Property in Sec. | S _____ T _____ R _____ | _____ |
| | S _____ T _____ R _____ | _____ |
4. Lot No. _____, Recorded Plat _____
5. Private Claims _____

	A	B	C	D	E	F	G	H	I	J	K	L	M
2	8		5		4		3		2		1		
3					●								
4	7		6		9		10		11		12		
5													
6	18		17		16		15		14		13		
7													
8	19		20		21		22		23		24		
9													
10	30		29		28		27		26		25		
11													
12	31		32		33		34		35		36		
13													

RICHARD H. KRAFT, PS, in a field survey on OCTOBER 10, 1994 do hereby certify that under requirements of P.A. 74, Michigan P.A. of 1970, the corner points mentioned in lines 1 and 2 above were in conformance with regulations and rules therefore as required in the current manual of survey instructions of the United States Department of the Interior, Bureau of Land Management or by a decree of a Court of Law and/or that the corner points mentioned in lines 3, 4 and 5 above were in conformance with the rules of the Michigan Board of Land Surveyors or by a Decree of a Court of Law; established, re-established, monumented, re-monumented, recovered, found as expressed below:

NOTE: Not more than 4 corners, all in the same town and range, may be recorded on this certificate.


- A. Description of original monument and accessories and/or subsequent restoration:
- 1823/GLO, HARVEY PARKE, DS, SET POST, NO ACCESSORIES
 - 1862/STEPHEN MATHERSON, CO. SUR. - FOUND POST & BRICK, NO ACCESSORIES
 - 1921/GCRC, FOUND STONE & BRICK, SET 5 ACCESSORIES
 - 1990/MARK VANRAEMDONCK, RLS, SET REROD & CAP UNDER STONE, RECORDED 4 ACCESSORIES, LIBER 2396, PAGE 974

- B. Description of corner evidence found and/or method applied in restoring or reestablishing corner:
- 1994- RICHARD H. KRAFT, RLS - FOUND 1/2" RE-ROD & CAP (LANDMARK)
- FOUND 3 OF RAEMDONCK RECORDED ACCESSORIES
 - S15°W, NAIL & TAG IN 10" WALNUT, 25.70' (MEASURED 25.9')
 - S80°E, NAIL & TAG IN 30" OAK, 96.10' (MEASURED 95.9')
 - N25°E, NAIL & TAG IN 6" PINE, 49.53' (MEASURED 49.8')

Ratified by Peer Group in accordance with P.A. 345, 1990
 Co. Rep. Paul D. Carlson
 Date 12-21-94

RATIFIED BY GENESEE COUNTY PEER GROUP, DECEMBER 21, 1994

- C. Description of monument for corner and accessories established to perpetuate locating the position of the corner:
- E-3 - RICHARD H. KRAFT SET STANDARD GENESEE COUNTY MONUMENT IN MONUMENT BOX
- N35°E, SET PK & GC TAG IN 10" PINE, 49.8'
 - S80°E, FOUND NAIL & TAG (LANDMARK) 36" OAK, 95.9'
 - S10°W, SET PK & GC TAG IN 12" ASH, 25.9'
 - S60°W, SET PK & GC TAG IN 12" ASH, 41.3'

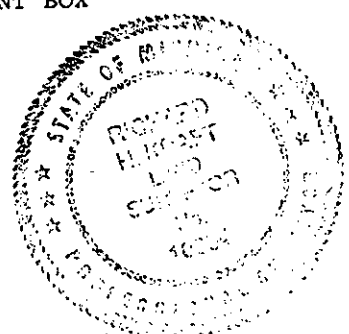

Signed by Richard H. Kraft
 Surveyor's Michigan License No. 10064

Date DECEMBER 31, 1994