

SURVEY & REMONUMENTATION

APR 27 1995

1994 REMONUMENTATION PROGRAM
LAND CORNER RECORDATION CERTIFICATE
Filing Requirement of Act 74, Mich. P.A. 1970

DEED
LIBER **2565** PAGE **895**

COMMISSION

For corners in

<u>GENESEE</u> <small>(County)</small>	Located In:	Corner Code <i>≠</i>
	ARGENTINE TOWNSHIP	
1. Public Land Survey	T <u>5N</u> R <u>5E</u>	F-3
	T _____ R _____	_____
	T _____ R _____	_____
	T _____ R _____	_____
2. Property Controlling in Section	S _____ T _____ R _____	_____
	S _____ T _____ R _____	_____
3. Miscellaneous Property in Sec.	S _____ T _____ R _____	_____
	S _____ T _____ R _____	_____
4. Lot No. _____, Recorded Plat _____		
5. Private Claims _____		

7805

FEB 16 7 38 AM 1995
RECORDED
REGISTERED
REGISTER OF DEEDS STAMP & FILE NUMBER

I, RICHARD H. KRAFT PS, in a field survey on OCTOBER 10, 19 94, do hereby certify that under requirements of P.A. 74, Michigan P.A. of 1970, the corner points mentioned in lines 1 and 2 above were in conformance with regulations and rules therefore as required in the current manual of survey instructions of the United States Department of the Interior, Bureau of Land Management or by a decree of a Court of Law and/or that the corner points mentioned in lines 3, 4 and 5 above were in conformance with the rules of the Michigan Board of Land Surveyors or by a Decree of a Court of Law; established, re-established, monumented, re-monumented, recovered, found as expressed below:

NOTE: Not more than 4 corners, all in the same town and range, may be recorded on this certificate.

A	B	C	D	E	F	G	H	I	J	K	L	M
2	8	9	4	3	2	1						
3												
4	7	8	9	10	11	12						
5												
6	18	17	16	15	14	13						
7												
8	19	20	21	22	23	24						
9												
10	30	29	28	27	26	25						
11												
12	31	32	33	34	35	36						
13												


A. Description of original monument and accessories and/or subsequent restoration:
 1823/GLO - HARVEY PARKE, D.S. SET POST, NO ACCESSORIES
 1890/MOSES MIDDLETON, COUNTY SURVEYOR, FOUND POST & BRICK, NO ACCESSORIES
 1979/JAN FOLKENS, RLS. - FOUND 1/2" ROD, SET NEW 1/2" ROD, RECORDED 3 ACCESSORIES
 LIBER 2034, PAGE 356

B. Description of corner evidence found and/or method applied in restoring or reestablishing corner:
 1994 - RICHARD H. KRAFT, FOUND 1/2" IRON
 FOUND JAN FOLKENS ACCESSORIES
 N45°EM PK & DISC. - 12" HICKORY, 43.61' (MEASURED 43.95')
 S45°W, SET PK & DISC - POWER POLE, 66.25' (MEASURED 66.0')
 N05°W, SET PK & DISC-E. FACE 18" HICKORY, 57.72'

Ratified by Peer Group in
accordance with P.A. 345, 1990
Co. Rep. Carl D. Carlson
Date 12-21-94

RATIFIED BY GENESEE COUNTY PEER GROUP, DECEMBER 21, 1994.

C. Description of monument for corner and accessories established to perpetuate locating the position of the corner:
 F-3 SET GENESEE COUNTY STANDARD MONUMENTS IN MONUMENT BOX
 N30°E, SET PK & G.C. TAG IN POWER POLE, 60.75'
 N60°E, SET PK & GC TAG IN 16" HICKORY, 43.95'
 S45°W, FOUND PK & WASHER IN POWER POLE, 66.0'
 N70°W, SET PK & GC TAG IN 18" HICKORY, 79.65'

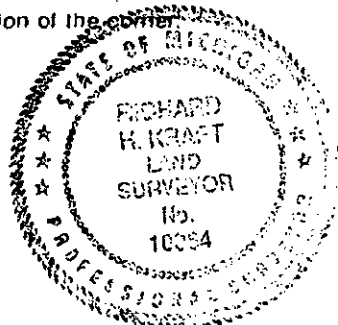

Signed by Richard H. Kraft Date DECEMBER 31, 1994
 Surveyor's Michigan License No. 10064