

SURVEY & REMONUMENTATION

MAY 31 2000

SECTION

Remonumentation corner under P.A. 345, Michigan P.A. of 1990

LAND CORNER RECORDATION CERTIFICATE

Filing Requirement of Act 74, Mich. P.A. 1970

DEED LIBER

2562 PAGE

572

For corners in

Genesee (County)

Located In:

Corner Code --#

Argentine Township

- 1. Public Land Survey T T5NR R5E G-3
2. Property Controlling in Section S T R
3. Miscellaneous Property in Sec. S T R
4. Lot No. Recorded Plat
5. Private Claims

RECORDED REGISTER OF DEEDS GENESSEE COUNTY REGISTERED DEEDS 2095 Register of Deeds Stamp & File Number

Grid table with columns A-M and rows 2-13. A dot is marked at the intersection of column G and row 3.

I, James E. Kovas, PS, PE, in a field survey on September 27, 1994 do hereby certify that under requirements of P.A. 74, Michigan P.A. of 1970, the corner points mentioned in lines 1 and 2 above were in conformance with regulations and rules therefore as required in the current manual of survey instructions of the United States Department of the Interior, Bureau of Land Management or by a decree of a Court of Law and/or that the corner points mentioned in lines 3, 4 and 5 above were in conformance with the rules of the Michigan Board of Land Surveyors or by a Decree of a Court of Law; established, re-established, monumented, re-monumented, recovered, found as expressed below:

NOTE: Not more than 4 corners, all in the same town and range, may be recorded on this certificate.

A. Description of original monument and accessories and/or subsequent restoration:

- 1823/GLO - John Mullett, DS, set post, two accessories
1847/RODeeds - No monument description, County Surveyor Post Witness Book, two accessories
1973/RODeeds - Recorded survey D.L. 1875 P. 295, Karol R. Piotrowski, RLS #9685, set 3/4" pinch pipe, four accessories
1973/RODeeds - L.C.R.C. D.L. 1872 P. 823, Karol R. Piotrowski, RLS #9685, set 3/4" pinch pipe, four accessories
1992/RODeeds - L.C.R.C. D.L. 2472 P. 666, A. Vance Kupisch, RLS #13586, four accessories

Ratified by Peer Group in accordance with P.A. 345, 1990 Co. Rep. Date Oct 25, 1994

B. Description of corner evidence found and/or method applied in restoring or reestablishing corner:


Table with columns for description, distance, and 'MEASURED' status. Includes entries for 1994 Remonun., 1973/RODeeds, and 1992/RODeeds.

Ratified by Genesee County Peer Group, October 25, 1994

C. Description of monument for corner and accessories established to perpetuate locating the position of the corner:

- ACCESSORIES: 1994 Remonun., Found 1/2" re-rod, Wade-Trim, Inc. Remonumentation G3 to H3=2671.92' (G.P.S.)
North 39.15' to Nail/tag in R.R. Tie
N90E 83.45' Nail/tag at C.L. C.L. Rail Road Tracks & Smith Rd
S10E 28.74' S. end 4' Diameter C.M.P.
S20W 34.64' to Nail/tag in 6" Maple

I set the standard 30" x 2 3/8" Bernts... with brass remonumentation cap over 1/2" re-rod.

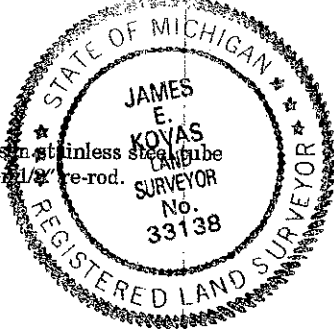

Signed by James E. Kovas Date 12/6/94 Surveyor's Michigan License No. 33138

87