

**SURVEY & REMONUMENTATION**

MAY 31 2000

Remonumentation corner under P.A. 345, Michigan P.A. of 1990

**LAND CORNER RECORDATION CERTIFICATE**  
Filing Requirement of Act 74, Mich. P.A. 1970

DEED LIBER

2562 PAGE 555

For corners in SECTION

Genesee  
(County)

Located In:

Corner Code #

Argentine Township

- |                                       |   |     |   |     |     |
|---------------------------------------|---|-----|---|-----|-----|
| 1. Public Land Survey                 | T | T5N | R | R5E | M-3 |
|                                       | T |     | R |     |     |
|                                       | T |     | R |     |     |
|                                       | T |     | R |     |     |
| 2. Property Controlling in Section    | S |     | T |     | R   |
|                                       | S |     | T |     | R   |
| 3. Miscellaneous Property in Sec.     | S |     | T |     | R   |
|                                       | S |     | T |     | R   |
| 4. Lot No. _____, Recorded Plat _____ |   |     |   |     |     |
| 5. Private Claims _____               |   |     |   |     |     |

RECORDED  
REGISTERED  
JAN 12 8 47 AM '95  
GENESEE COUNTY REGISTER OF DEEDS  
2078  
Register of Deeds Stamp & File Number

9.00 Filed & Recd

A	B	C	D	E	F	G	H	I	J	K	L	M
2	6		5		4		3		2		1	
3												
4	7		8		9		10		11		12	
5												
6	18		17		16		15		14		13	
7												
8	19		20		21		22		23		24	
9												
10	30		29		28		27		26		25	
11												
12	31		32		33		34		35		36	
13												

I, James E. Kovas, PS, PE in a field survey on September 27, 19 94, do hereby certify that under requirements of P.A. 74, Michigan P.A. of 1970, the corner points mentioned in lines 1 and 2 above were in conformance with regulations and rules therefore as required in the current manual of survey instructions of the United States Department of the Interior, Bureau of Land Management or by a decree of a Court of Law and/or that the corner points mentioned in lines 3, 4 and 5 above were in conformance with the rules of the Michigan Board of Land Surveyors or by a Decree of a Court of Law; established, re-established, monumented, re-monumented, recovered, found as expressed below:

**NOTE: Not more than 4 corners, all in the same town and range, may be recorded on this certificate.**

A. Description of original monument and accessories and/or subsequent restoration:

- 1823/GLO - John Mullett, DS, set post, two accessories
- 1847/RODeeds - No monument description, County Surveyor Post Witness Book, two accessories
- 1978/Survey - Found 1 1/4" pipe with Delta cap, Unrecorded Survey by Alpha Surveying Job No. 78-124, RLS #23518, four accessories
- 1983/Survey - Found 1 1/4" pipe with Delta cap, Unrecorded Survey by Alpha Surveying Job No. 78-124, RLS #23518, four accessories

Ratified by Peer Group in accordance with P.A. 345, 1990  
Co. Rep. Carl Carlson  
Date Oct 25, 1994

B. Description of corner evidence found and/or method applied in restoring or reestablishing corner:

<b>1994/REMON. SUMMARY OF EXISTING ACCESSORIES</b>		<b>MEASURED</b>
1994/Remon Found 1 1/4" Pipe, Wade-Trim, Inc. Remonumentation		
1978/Survey - South 24.3' Spk./w East Side 16" Oak (now 20")	(measured to center)	24.3'
& 1983/Survey		


Ratified by Genesee County Peer Group, October 25, 1994.

C. Description of monument for corner and accessories established to perpetuate locating the position of the corner:

**ACCESSORIES:**

- 1994/Remon Found 1 1/4" Pipe, Wade-Trim, Inc. Remonumentation
- South 24.30' to Nail/tag in E. Face of 20" Oak
- S60E 53.65' to Nail/in NE Face of 14" Oak
- S70W 57.91' to Nail/tag in N Face of 10" Oak
- N30E 18.09' to Center of Argentine Twp. sign post

I set the standard 30"X2 3/8" Berntsen stainless steel tube with brass remonumentation cap over the 1 1/4" Pipe.

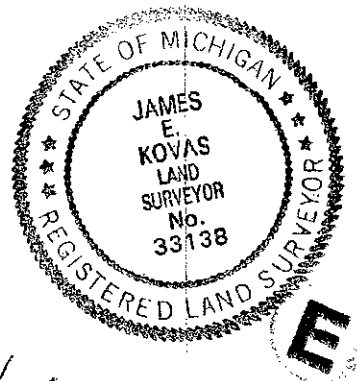

Signed by James E. Kovas Date 12/6/94

Surveyor's Michigan License No. 33138

83