

**SURVEY & REMONUMENTATION**

MAY 31 2000

Remonumentation corner under P.A. 345, Michigan P.A. of 1990

**SECTION**

**LAND CORNER RECORDATION CERTIFICATE**

Filing Requirement of Act 74, Mich. P.A. 1970

DEED LIBER 2562 PAGE 562

For corners in

Genesee


(County)

Located In:

Corner Code #

Fenton Township

- |                                      |   |     |   |     |     |
|--------------------------------------|---|-----|---|-----|-----|
| 1. Public Land Survey                | T | T5N | R | R6E | L-3 |
|                                      | T |     | R |     |     |
|                                      | T |     | R |     |     |
|                                      | T |     | R |     |     |
| 2. Property Controlling in Section   | S |     | T |     | R   |
|                                      | S |     | T |     | R   |
| 3. Miscellaneous Property in Sec.    | S |     | T |     | R   |
|                                      | S |     | T |     | R   |
| 4. Lot No. _____ Recorded Plat _____ |   |     |   |     |     |
| 5. Private Claims _____              |   |     |   |     |     |

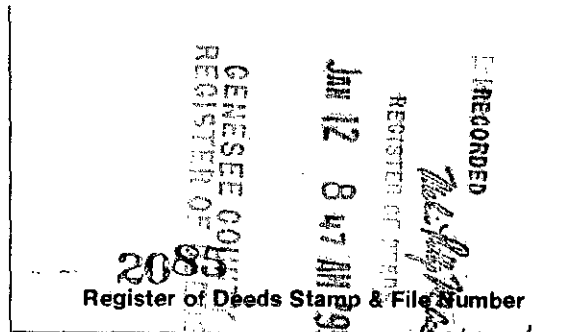

*9.00 Filed & Recd*

	A	B	C	D	E	F	G	H	I	J	K	L	M
2	6		5		4		3		2		1		
3													
4	7		8		9		10		11		12		
5													
6	18		17		16		15		14		13		
7													
8	19		20		21		22		23		24		
9													
10	30		29		28		27		26		25		
11													
12	31		32		33		34		35		36		
13													

I, James E. Kovas, PS, PE, in a field survey on September 27, 1994, do hereby certify that under requirements of P.A. 74, Michigan P.A. of 1970, the corner points mentioned in lines 1 and 2 above were in conformance with regulations and rules therefore as required in the current manual of survey instructions of the United States Department of the Interior, Bureau of Land Management or by a decree of a Court of Law and/or that the corner points mentioned in lines 3, 4 and 5 above were in conformance with the rules of the Michigan Board of Land Surveyors or by a Decree of a Court of Law; established, re-established, monumented, re-monumented, recovered, found as expressed below:

**NOTE: Not more than 4 corners, all in the same town and range, may be recorded on this certificate.**

A. Description of original monument and accessories and/or subsequent restoration:

- 1823/GLO - J. Fletcher, DS, set post, two accessories
- 1847/RODeeds - No monument description, County Surveyor Post Witness Book, two accessories
- 1994/RODeeds - No monument description, deed to Peabody, DL 2552, P 713

B. Description of corner evidence found and/or method applied in restoring or reestablishing corner:

**1994/REMON. SUMMARY OF EXISTING ACCESSORIES**  
 1994/Remon Found 1/2" Re-Rod, Wade-Trim, Inc.. Remonumentation

Ratified by Genesee County Peer Group December 7, 1994.


Ratified by Peer Group in accordance with P.A. 345, 1990

Co. Rep. Carl Carlson  
 Date Dec 7, 1994

C. Description of monument for corner and accessories established to perpetuate locating the position of the corner:

- ACCESSORIES:**
- 1994/Remon Found 1/2" Re-Rod, Wade-Trim, Inc.. Remonumentation
  - S10E 14.62' Nail/Remon-tag in E. face 40" Quin. Oak
  - S60E 5.71' Nail/Remon-tag in S. face 14" Popular
  - West 58.42' Nail/Remon-tag S. face 30" Ash
  - N10E 12.90 Nail/Remon-tag E. face 12" Beech

I set the standard 30" x 2 3/8" Bernstein stainless steel tube with brass remonumentation cap over 1/2" Re-Rod.

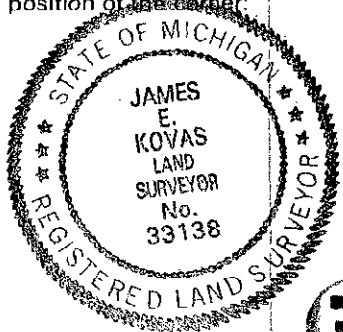

Signed by James E. Kovas Date 12/21/94  
 Surveyor's Michigan License No. 33138

88