

**1998 GENESEE COUNTY REMONUMENTATION PROGRAM  
LAND CORNER RECORDATION CERTIFICATE  
Filing Requirement of Act 74, Mich. P.A. 1970**

MASTER  
LIVER 4018 PAGE 96

For corners in

Genesee County Located In: \_\_\_\_\_ Corner Code # \_\_\_\_\_

1. Public Land Survey T5N R6E L-5

2. Property Controlling S \_\_\_\_\_ T \_\_\_\_\_ R \_\_\_\_\_  
in Section S \_\_\_\_\_ T \_\_\_\_\_ R \_\_\_\_\_ SURVEY &  
3. Miscellaneous S \_\_\_\_\_ T \_\_\_\_\_ R \_\_\_\_\_ REMONUMENTATION  
Property in Sec. S \_\_\_\_\_ T \_\_\_\_\_ R \_\_\_\_\_

4. Lot No. \_\_\_\_\_, Recorded Plat \_\_\_\_\_  
5. Private Claims \_\_\_\_\_ SECTION \_\_\_\_\_

MAR 17 1999

**GENESEE COUNTY  
REGISTER OF DEEDS**

Dec 11 10 53 AM '98  
*McL...*

106824

Register Number Deeds Stamp & Fee

A	B	C	D	E	F	G	H	I	J	K	L	M
1												
2	6		5		4		3		2		1	
3												
4	7		8		9		10		11		12	
5												
6	18		17		16		15		14		13	
7												
8	19		20		21		22		23		24	
9												
10	30		29		28		27		26		25	
11												
12	31		32		33		34		35		36	
13												

I, Kevin B. Cleaver, in a field survey on November 30, 1998, do hereby state that under requirements of P.A. 74, Michigan P.A. of 1970, the corner points mentioned in lines 1 and 2 above were in conformance with regulations and rules therefore as required in the current manual of survey instructions of the United States Department of the Interior, Bureau of Land Management or by a decree of a Court of Law and /or that the corner points mentioned in lines 3, 4 and 5 above were in conformance with the rules of the Michigan Board of Land Surveyors or by a Decree of a Court of Law; established, re-established, monumented, recovered, found as expressed below:

**NOTE: Not more than 2 corners, all in the same town and range, may be recorded on this certificate.**

**A. Description of original monument and accessories and/or subsequent restoration:**

4-15-1823 General Land Office (GLO) fieldnotes: set post w/two accessories  
8-29-1989 unrecorded survey by A.F. Miller in SW 1/4 Section 12: set rerod/cap #12024 with four accessories

**B. Description of corner evidence found and/or method applied in restoring or reestablishing corner:**

GLO corner and accessories not found  
Recovered corner and two accessories from 1989 survey by A.F. Miller

The monument found was ratified by the Genesee County Remonumentation Peer Review Committee on November 18, 1998

**C. Description of monument for corner and accessories established to perpetuate locating the position of the corner:**


Set the standard Bernsten monument SS-A-5BR-30 with 3 1/4" brass cap stamped "Genesee County Remonumentation Corner, 1998, #29242" over found 1/2" rerod w/cap #12024

S 30° W 27.94' found PK nail/disk "GW 04799" in E face 10" tree  
N 45° W 17.52' found PK nail/disk "GW 4800" in SE face 20" oak  
N 45° E 16.18' found PK nail in W face 12" maple  
EAST 25.13' found PK nail W face 18" twin maple

**Ratified by Peer Group in accordance with P.A. 345, 1990**

Co. Rep. Carl Carlson  
Date 11-18-98

Signed by Kevin Banfield Cleaver Date 12/3/98  
Kevin Banfield Cleaver, P.S.

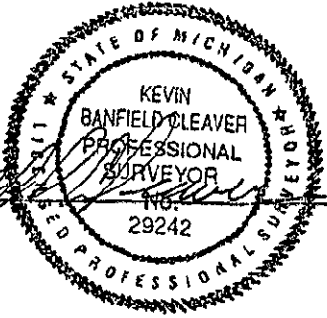

Surveyor's Michigan License No. 29242

DGR/tb  
98-GCRM-DGR-2825