

**SURVEY & REMONUMENTATION**

MAY 31 2000

**SECTION**

Remonumentation corner under P.A. 345, Michigan P.A. of 1990

**LAND CORNER RECORDATION CERTIFICATE** DEED LIBER 2562 PAGE 439  
 Filing Requirement of Act 74, Mich. P.A. 1970

For corners in Genesee

(County)	Located In:	Corner Code #
	Fenton Township	
1. Public Land Survey	T <u>T5N</u> R <u>R6E</u>	<u>M-6</u>
	T _____ R _____	_____
	T _____ R _____	_____
	T _____ R _____	_____
2. Property Controlling in Section	S _____ T _____ R _____	_____
	S _____ T _____ R _____	_____
3. Miscellaneous Property in Sec.	S _____ T _____ R _____	_____
	S _____ T _____ R _____	_____

RECORDED  
 REGISTER OF DEEDS  
 JUNE 11 11 45 AM '95  
 GENESSEE COUNTY REGISTER OF DEEDS  
 1873  
 Register of Deeds Stamp & File Number

4. Lot No. \_\_\_\_\_, Recorded Plat \_\_\_\_\_  
 5. Private Claims \_\_\_\_\_

9.00 Filed & Keed

	A	B	C	D	E	F	G	H	I	J	K	L	M
2	6		5		4		3		2		1		
3													
4	7		8		9		10		11		12		
5													
6	18		17		16		15		14		13		
7													
8	19		20		21		22		23		24		
9													
10	30		29		28		27		26		25		
11													
12	31		32		33		34		35		36		
13													

I, James E. Kovas, PS, PE in a field survey on September 27, 1994, do hereby certify that under requirements of P.A. 74, Michigan P.A. of 1970, the corner points mentioned in lines 1 and 2 above were in conformance with regulations and rules therefore as required in the current manual of survey instructions of the United States Department of the Interior, Bureau of Land Management or by a decree of a Court of Law and/or that the corner points mentioned in lines 3, 4 and 5 above were in conformance with the rules of the Michigan Board of Land Surveyors or by a Decree of a Court of Law; established, re-established, monumented, re-monumented, recovered, found as expressed below:

**NOTE: Not more than 4 corners, all in the same town and range, may be recorded on this certificate.**

**A. Description of original monument and accessories and/or subsequent restoration:**

1823/GLO - J. Fletcher, DS, no post set, corner in a very bad swamp on the East of the lake  
 847/RODeeds - No monument description, County Surveyor Post Witness Book, no accessories

Ratified by Peer Group in accordance with P.A. 345, 1990

Co. Rep. Carl Carlson  
 Date November 23, 1994

**B. Description of corner evidence found and/or method applied in restoring or reestablishing corner:**

**1994/REMON. SUMMARY OF EXISTING ACCESSORIES**

1994/Remon Set 1/2" by 4' Re-Rod in the root of a 38" Maple located in a bad swamp  
 This corner was reestablished using single proportionate measurement in conjunction with both G.P.S. and terrestrial surveying techniques. Corner M5 and M7 were recovered employed for this procedure. The resulting measurements are shown


GPS BEARING	MEASURED
S03-22-32E	2673.54'
S03-22-32E	2673.54'
S03-22-32E	5347.08'

Ratified by Genesee County Peer Group November 23, 1994.

**C. Description of monument for corner and accessories established to perpetuate locating the position of the corner:**

**ACCESSORIES:**

1994/Remon Set 1/2" by 4' Re-Rod in the root of a 38" Maple located in a bad swamp  
 N60W 16.77' to Nail/Remon-tag S face 24" Maple  
 S50W 17.40' to Nail/Remon-tag N face 26" Maple  
 South 3.73' to Nail/Remon-tag W face twin 38" Maple  
 N40E 51.68' to Nail/Remon-tag S face 30" Maple

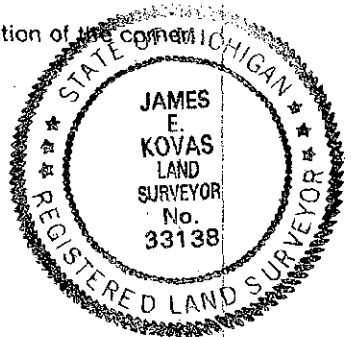

Signed by James E. Kovas Date 12/14/94  
 Surveyor's Michigan License No. 33138

79