

SURVEY & REMONUMENTATION

MAY 31 2000

Remonumentation corner under P.A. 345, Michigan P.A. of 1990

SECTION

LAND CORNER RECORDATION CERTIFICATE

Filing Requirement of Act 74, Mich. P.A. 1970

DEED LIBER 2562 PAGE 566

For corners in

Genesee
(County)

Located In:

Corner Code #

- Fenton Township
1. Public Land Survey T T5N R R6E M-11
- T R
- T R
- T R
2. Property Controlling S T R
- in Section S T R
3. Miscellaneous S T R
- Property in Sec S T R
4. Lot No. _____, Recorded Plat _____
5. Private Claims _____

RECORDED

REGISTERED DEEDS

JAN 12 8 47 AM '95

GENESEE COUNTY REGISTER

2089

Register of Deeds Stamp & File Number

9.00 Filed & Recd

	A	B	C	D	E	F	G	H	I	J	K	L	M
2	6	5	4	3	2								
3													
4	7	8	9	10	11	12							
5													
6	13	17	16	15	14	13							
7													
8	19	20	21	22	23	24							
9													
10	30	29	28	27	26	25							
11													
12	31	32	33	34	35	36							
13													

I, James E. Kovas, PS, PE in a field survey on September 27, 1994, do hereby certify that under requirements of P.A. 74, Michigan P.A. of 1970, the corner points mentioned in lines 1 and 2 above were in conformance with regulations and rules therefore as required in the current manual of survey instructions of the United States Department of the Interior, Bureau of Land Management or by a decree of a Court of Law and/or that the corner points mentioned in lines 3, 4 and 5 above were in conformance with the rules of the Michigan Board of Land Surveyors or by a Decree of a Court of Law; established, re-established, monumented, re-monumented, recovered, found as expressed below:

NOTE: Not more than 4 corners, all in the same town and range, may be recorded on this certificate.

A. Description of original monument and accessories and/or subsequent restoration:

- 1823/GLO - J. Fletcher, DS, set post, two accessories
- 1847/RODecds - No monument description, County Surveyor Post Witness Book, no accessories
- 1991/Survey - No monument description, unrecorded survey by Cornerstone Surveying & Engineering, Inc., G. Bonno, RLS #32332, no accessories shown

B. Description of corner evidence found and/or method applied in restoring or reestablishing corner:

1994/REMON. SUMMARY OF EXISTING ACCESSORIES
1994/Remon Found P.K. Nail per Cornerstone Survey, Job No. S1-519, for Bob Gibbs

MEASURED
M10 to M11 2655.76'

Ratified by Genesee County Peer Group December 7, 1994.


Ratified by Peer Group in accordance with P.A. 345, 1990

Co. Rep. Paul Carlson
Date Dec 7, 1994

C. Description of monument for corner and accessories established to perpetuate locating the position of the corner:

- ACCESSORIES:**
- 1994/Remon Found P.K. Nail per Cornerstone Survey, Job No. S1-519, for Bob Gibbs
 - N45E 75.93' to G. Bonno tag in P. Pole
 - South 24.43' to G. Bonno tag in P. Pole
 - N45W 44.22' to Nail/Remon-tag in NE face 16" Pine
 - S60W 58.81 to Nail/Remon-tag in N face P. Pole

I set the standard 30" x 2 3/8" Bernsten stainless steel tube with brass remonumentation cap in place of P.K. Nail.

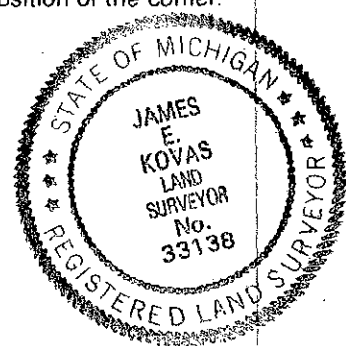

Signed by James E. Kovas
Surveyor's Michigan License No. 33138

Date 12/21/94

92