

1998 GENESEE COUNTY REMONUMENTATION PROGRAM
 LAND CORNER RECORDATION CERTIFICATE
 Filing Requirement of Act 74, Mich. P.A. 1970

MASTER LIBER 4178 PAGE 191

For corners in

Genesee County Located In: Corner Code #

1. Public Land Survey	T	R	
2. Property Controlling in Section	S11/12	T5N	R6E
3. Miscellaneous Property in Sec.	S	T	R
	S	T	R
	S	T	R

Reference Monument Seg. 2

4. Lot No. _____, Recorded Plat _____

5. Private Claims _____

GENESEE COUNTY REGISTER OF DEEDS

JUN 8 2 40 PM '99

Michele P. ...

Register of Deeds Stamp & File Number

	A	B	C	D	E	F	G	H	I	J	K	L	M
1													
2		6		5		4		3		2		1	
3													
4		7		8		9		10		11		12	
5													
6		18		17		16		15		14		13	
7													
8		19		20		21		22		23		24	
9													
10		30		29		28		27		26		25	
11													
12		31		32		33		34		35		36	
13													

I, Kevin B. Cleaver, in a field survey on May 4, 1999 do hereby state that under requirements of P.A. 74, Michigan P.A. of 1970, the corner points mentioned in lines 1 and 2 above were in conformance with regulations and rules therefore as required in the current manual of survey instructions of the United States Department of the Interior, Bureau of Land Management or by a decree of a Court of Law and for that the corner points mentioned in lines 3, 4 and 5 above were in conformance with the rules of the Michigan Board of Land Surveyors or by a Decree of a Court of Law; established, re-established, monumented, recovered, found as expressed below:

NOTE: Not more than 2 corners, all in the same town and range, may be recorded on this certificate.

A. Description of original monument and accessories and/or subsequent restoration:

This reference monument was not set as part of the original G.L.O. Survey

SURVEY & REMONUMENTATION

OCT 13 1999

SECTION

B. Description of corner evidence found and/or method applied in restoring or reestablishing corner:

Set reference monument for K-4 on line with K-4 and K-5, 8.00' North of K-4. K-4 and K-5 locations were both ratified by the Genesee County Remonumentation Peer Review Committee on November 18, 1998.

C. Description of monument for corner and accessories established to perpetuate locating the position of the corner:


Set the standard Bernsten monument SS-A-SBR-30 with 3/4" brass cap stamped "Genesee County Remonumentation Corner, 1998, #29242" in lawn North of concrete drive.

- S 15° E 17.50' NW corner of detached wood garage
- S 20° W 26.23' found nail in E face 10" hickory
- S 65° W 28.15' found nail in NW face 18" oak
- N 40° W 21.64' set nail/tag in SW face 12" hickory
- South 8.00' found chiseled "x" in concrete driveway (corner K-4)

Ratified by Peer Group in accordance with P.A. 345, 1990

Co. Rep. Carl ...
 Date Nov 18, 1998

Signed by Kevin Banfield Cleaver
 Kevin Banfield Cleaver, P.S.
 Surveyor's Michigan License No. 29242

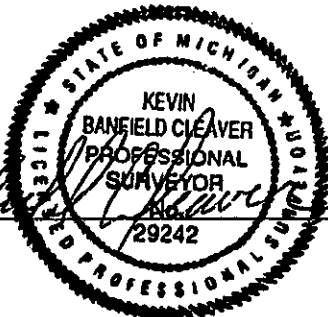

Date 6/3/99

49535

\$9.00 Filed & Rec'd