

MAY 31 2000

1994 REMONUMENTATION PROGRAM

DEED LIBER 2565 PAGE 865

SECTION

LAND CORNER RECORDATION CERTIFICATE
Filing Requirement of Act 74, Mich. P.A. 1970

For corners in

| | | |
|------------------------------------|-------------------------|---------------|
| <u>GENESEE</u> (County) | Located in: | Corner Code # |
| | GAINES | A-3 |
| 1. Public Land Survey | T <u>6N</u> R <u>5E</u> | _____ |
| | T _____ R _____ | _____ |
| | T _____ R _____ | _____ |
| | T _____ R _____ | _____ |
| 2. Property Controlling in Section | S _____ T _____ R _____ | _____ |
| | S _____ T _____ R _____ | _____ |
| 3. Miscellaneous Property in Sec. | S _____ T _____ R _____ | _____ |
| | S _____ T _____ R _____ | _____ |

RECORDED
FEB 16 7 37 AM '95
REGISTERED
7775
Register of Deeds Stamp & File Number
900 filed a rec

- 4. Lot No. _____, Recorded Plat _____
- 5. Private Claims _____

| A | B | C | D | E | F | G | H | I | J | K | L | M |
|----|----|----|----|----|----|----|---|---|---|---|---|---|
| 2 | 6 | 5 | 4 | 3 | 2 | 1 | | | | | | |
| 3 | | | | | | | | | | | | |
| 4 | 7 | 8 | 9 | 10 | 11 | 12 | | | | | | |
| 5 | | | | | | | | | | | | |
| 6 | 18 | 17 | 16 | 15 | 14 | 13 | | | | | | |
| 7 | | | | | | | | | | | | |
| 8 | 19 | 20 | 21 | 22 | 23 | 24 | | | | | | |
| 9 | | | | | | | | | | | | |
| 10 | 30 | 29 | 28 | 27 | 26 | 25 | | | | | | |
| 11 | | | | | | | | | | | | |
| 12 | 31 | 32 | 33 | 34 | 35 | 36 | | | | | | |
| 13 | | | | | | | | | | | | |

RICHARD H. KRAFT, P.S.S. in a field survey on, NOVEMBER 7, 19 94, do hereby certify that under requirements of P.A. 74, Michigan P.A. of 1970, the corner points mentioned in lines 1 and 2 above were in conformance with regulations and rules therefore as required in the current manual of survey instructions of the United States Department of the Interior, Bureau of Land Management or by a decree of a Court of Law and/or that the corner points mentioned in lines 3, 4 and 5 above were in conformance with the rules of the Michigan Board of Land Surveyors or by a Decree of a Court of Law; established, re-established, monumented, re-monumented, recovered, found as expressed below:

NOTE: Not more than 4 corners, all in the same town and range, may be recorded on this certificate.

A. Description of original monument and accessories and/or subsequent restoration:

- 1823 JOHN MULLETT, D.S. - SET POST - NO ACCESSORIES
- 1919 GCRC - FOUND BRICK & STONE (SET IRON PIN) - SET 5 ACCESSORIES
- 1974 KAROL PIOTROWSKI, R.L.S. - FOUND 3/8" STEEL PIN - REC. 4 ACCESSORIES - L. 1908, PAGE 517
- MARK VANRAEMDONCK, R.L.S. - FOUND RE-ROD - REC. 3 ACCESSORIES - L. 2314, PAGE 334
- 1990 GILBERT BONNO, R.L.S. - FOUND 1/4" RE-ROD, REC. 3 ACCESSORIES - L. 2409, PAGE 779

B. Description of corner evidence found and/or method applied in restoring or reestablishing corner:

- 1990 GILBERT BONNO, R.L.S. - FOUND 1/4" RE-ROD
- N30°W 7" ELM 63.98' (MEASURED 62.9')
- S30°E 6" ASH 117.81' (MEASURED 118.11')


Ratified by Peer Group in accordance with P.A. 345, 1990

Co. Rep. Carl H. Carlson
Date 12-28-94

RATIFIED BY GENESEE COUNTY PEER GROUP DECEMBER 28, 1994.

C. Description of monument for corner and accessories established to perpetuate locating the position of the corner:

- A-3 SET STANDARD GENESEE COUNTY MONUMENT IN MONUMENT BOX
- N40°E SIGN POST 45.72'
- S70°E SET P.K. & GC TAG IN 24" HICKORY 62.9'
- S50°E SET P.K. & GC TAG IN 6" ASH 118.1'
- N85°W ARROW SIGN N. LEG 31.9'

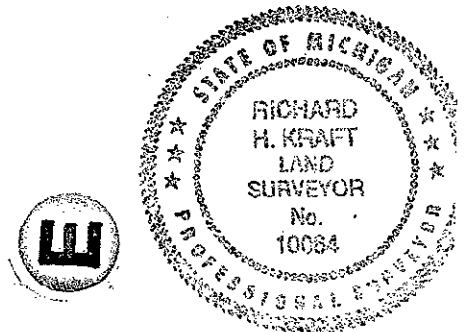

Signed by Richard H. Kraft Date DECEMBER 31, 1994
Surveyor's Michigan License No. 10064

59

7775