

**SURVEY &
REMONUMENTATION**

APR 27 1995

1994 REMONUMENTATION PROGRAM

DEED LIBER 2565 PAGE 860

LAND CORNER RECORDATION CERTIFICATE


Filing Requirement of Act 74, Mich. P.A. 1970

For corners in **COMMISSION**

<u>GENESEE</u> <small>(County)</small>	Located In:	Corner Code <i>if</i>
	GAINES	
1. Public Land Survey	T <u>6N</u> R <u>5E</u>	<u>B-3</u>
	T _____ R _____	_____
	T _____ R _____	_____
	T _____ R _____	_____
2. Property Controlling in Section	S _____ T _____ R _____	_____
	S _____ T _____ R _____	_____
3. Miscellaneous Property in Sec.	S _____ T _____ R _____	_____
	S _____ T _____ R _____	_____

RECORDED
FEB 16 7 37 AM '95
7776
Register of Deeds Stamp & File Number

4. Lot No. _____, Recorded Plat _____
5. Private Claims _____

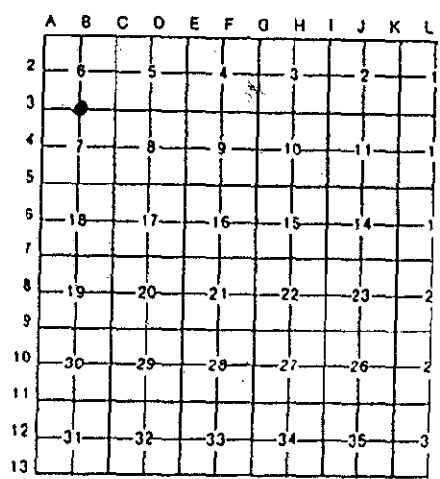

I, RICHARD H. KRAFT, PS in a field survey on NOVEMBER 7, 19 94, do hereby certify that under requirements of P.A. 74, Michigan P.A. of 1970, the corner points mentioned in lines 1 and 2 above were in conformance with regulations and rules therfore as required in the current manual of survey instructions of the United States Department of the Interior, Bureau of Land Management or by a decree of a Court of Law and/or that the corner points mentioned in lines 3, 4 and 5 above were in conformance with the rules of the Michigan Board of Land Surveyors or by a Decree of a Court of Law; established, re-established, monumented, re-monumented, recovered, found as expressed below:

NOTE: Not more than 4 corners, all in the same town and range, may be recorded on this certificate.

A. Description of original monument and accessories and/or subsequent restoration:

- 1823 GLO; JOHN MULLETT, D.S. - SET POST - NO ACCESSORIES
- 1920 GCRC - FOUND PLOW POINT-BRICK - SET 4 ACCESSORIES
- 1971 A.F. MILLER, R.L.S. - FOUND 1/2" RE-ROD - REC. 3 ACCESSORIES, L. 1838, PAGE 135
- KAROL PIOTROWSKI, R.L.S. - FOUND 3/4" PIPE - REC. 3 ACCESSORIES, L. 1908, PAGE 517

B. Description of corner evidence found and/or method applied in restoring or reestablishing corner:

1990 GILBERT BONNO, R.L.S. FOUND 1" PIPE - REC. IN L. 1990, PAGE 779

N70°E 16" CHERRY 82.08' (MEASURED 82.7')
S70°W 14" POPLAR 68.05 (MEASURED 68.0')

1994 RICHARD H. KRAFT, P.S. - FOUND 1" IRON

Ratified by Peer Group in accordance with P.A. 345, 1990

Co. Rep. Carl H. Carlson
Date 12-28-94


RATIFIED BY GENESEE COUNTY PEER GROUP DECEMBER 28, 1994

C. Description of monument for corner and accessories established to perpetuate locating the position of the corner:

SET STANDARD GENESEE COUNTY MONUMENT IN MONUMENT BOX

- N40°E FOUND NAIL & CAP (C. CARLSON) - POWER POLE
- N70°E FOUND NAIL & CAP (C. CARLSON) 24" CHERRY
- S60°W FOUND NAIL & WASHER - 36" POPLAR
- N45°E ROAD SIGN

36.15'
82.7'
68.0'
45.92'

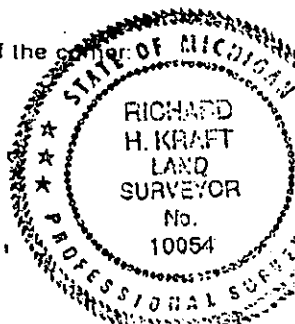

Signed by Richard H. Kraft Date DECEMBER 31, 1994

Surveyor's Michigan License No. 10064