

REMONUMENTATION

DEED LIBER 2565 PAGE 867

APR 27 1995

1994 REMONUMENTATION PROGRAM

COMMISSION

LAND CORNER RECORDATION CERTIFICATE  
Filing Requirement of Act 74, Mich. P.A. 1970

or corners in


<u>GENESEE</u> (County)	Located In:	Corner Code #/
Public Land Survey	GAINES T <u>6N</u> R <u>5E</u>	C-3
	T _____ R _____	_____
	T _____ R _____	_____
	T _____ R _____	_____
1. Property Controlling in Section	S _____ T _____ R _____	_____
	S _____ T _____ R _____	_____
2. Miscellaneous Property in Sec.	S _____ T _____ R _____	_____
	S _____ T _____ R _____	_____

RECORDED  
FEB 16 7 37 AM '95  
REGISTERED  
77777  
A. Miller  
filed

Register of Deeds Stamp & File Number

1. Lot No. \_\_\_\_\_, Recorded Plat \_\_\_\_\_  
 2. Private Claims \_\_\_\_\_

RICHARD H. KRAFT, PS in a field survey on NOVEMBER 7, 19 94, to hereby certify that under requirements of P.A. 74, Michigan P.A. of 1970, the corner points mentioned in lines 1 and 2 above were in conformance with regulations and rules therefore as required in the current manual of survey instructions of the United States Department of the Interior, Bureau of Land Management or by a decree of a Court of Law and/or that the corner points mentioned in lines 3, 4 and 5 above were in conformance with the rules of the Michigan Board of Land Surveyors or by a Decree of a Court of Law; established, re-established, monumented, re-monumented, recovered, found as expressed below:

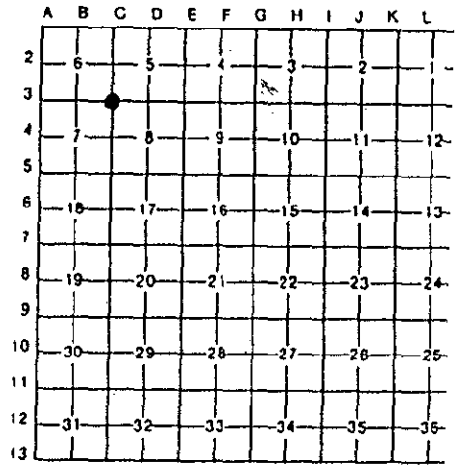

NOTE: Not more than 4 corners, all in the same town and range, may be recorded on this certificate.

1. Description of original monument and accessories and/or subsequent restoration:

- 1823 GLO; JOHN MULLETT, D.S. - SET POST - NO ACCESSORIES
- 1862 STEPHEN MATHERSON, GENESEE COUNTY SURVEYOR - FOUND POST & BRICK - NO ACCESSORIES
- 1919 GCRC - FOUND STONE - SET 5 ACCESSORIES
- 1971 A. MILLER, R.L.S. - FOUND 1/2" RE-ROD - REC. 3 ACCESSORIES, L. 1838, PAGE 135

3. Description of corner evidence found and/or method applied in restoring or reestablishing corner:

- 1971 DAVID T. ROWE, R.L.S. - FOUND IRON PIN - REC. 1971 - L. 1812, PAGE 468-469
- S45°W NE COR. GARAGE 118.9'
- N30°E NAIL IN POLE 71.15' (MEASURED 71.48')
- N30°E CONC. R/W MARKER 56.05'
- S55°E NAIL IN POLE 61.0' (MEASURED 61.58')


Ratified by Peer Group in accordance with P.A. 345, 1990  
 Co. Rep. Paul D. Carlson  
 Date 12-28-94

RATIFIED BY GENESEE COUNTY PEER GROUP DECEMBER 28, 1994

C. Description of monument for corner and accessories established to perpetuate locating the position of the corner:

SET STANDARD GENESEE COUNTY MONUMENT IN MONUMENT BOX

- N55°E NAIL & CAP IN POLE 71.48'
- S45°E FOUND NAIL & CAP IN LIGHT POLE 61.58'
- S60°W STOP SIGN - WEST EDGE 52.9'
- N45°W FOUND NAIL & WASHER - POWER POLE 76.98'

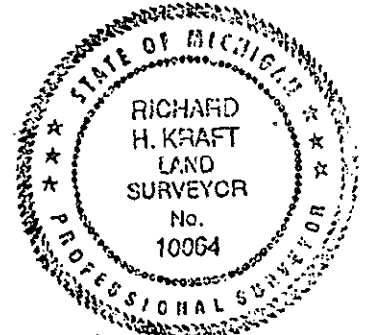

Signed by Richard H. Kraft Date DECEMBER 31, 1994  
 Surveyor's Michigan License No. 10064