

**SURVEY & REMONUMENTATION**

DEED LIBER 2565 PAGE 868

1994 REMONUMENTATION PROGRAM

APR 27 1995

**LAND CORNER RECORDATION CERTIFICATE**  
Filing Requirement of Act 74, Mich. P.A. 1970

for corners **COMMISSION**


GENESEE <small>(County)</small>	Located In: GAINES	Corner Code #1
1. Public Land Survey	T <u>6N</u> R <u>5E</u>	<u>D-3</u>
	T _____ R _____	_____
	T _____ R _____	_____
	T _____ R _____	_____
2. Property Controlling in Section	S _____ T _____ R _____	_____
	S _____ T _____ R _____	_____
3. Miscellaneous Property in Sec.	S _____ T _____ R _____	_____
	S _____ T _____ R _____	_____

REGISTERED  
FEB 16 7 37 AM 1995  
REGISTERED  
file

Register of Deeds Stamp & File Number

4. Lot No. \_\_\_\_\_, Recorded Plat \_\_\_\_\_  
5. Private Claims \_\_\_\_\_

I, RICHARD H. KRAFT, PS in a field survey on, NOVEMBER 8, 1994, do hereby certify that under requirements of P.A. 74, Michigan P.A. of 1970, the corner points mentioned in lines 1 and 2 above were in conformance with regulations and rules therefore as required in the current manual of survey instructions of the United States Department of the Interior, Bureau of Land Management or by a decree of a Court of Law and/or that the corner points mentioned in lines 3, 4 and 5 above were in conformance with the rules of the Michigan Board of Land Surveyors or by a Decree of a Court of Law; established, re-established, monumented, re-monumented, recovered, found as expressed below:

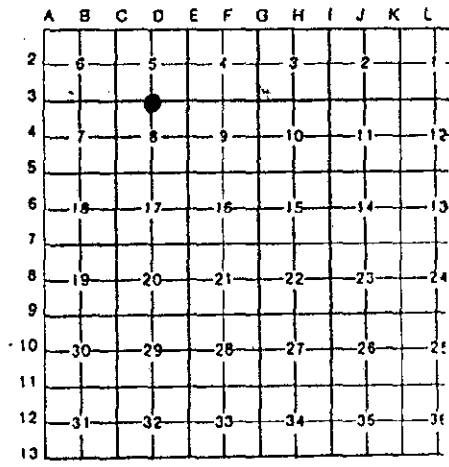

**NOTE:** Not more than 4 corners, all in the same town and range, may be recorded on this certificate.

**A. Description of original monument and accessories and/or subsequent restoration:**

- 1823 JOHN MULLETT, D.S. - SET POST - NO ACCESSORIES
- 1862 STEPHEN MATHERSON, GENESEE COUNTY SURVEYOR - FOUND S 1/4, SEC. 5 - NO ACCESSORIES
- 1919 GCRC - FOUND PLOW POINT - SET 5 ACCESSORIES

**B. Description of corner evidence found and/or method applied in restoring or reestablishing corner:**

1919 GCRC FOUND PLOW POINT

NORTH	A. POST	31.0'	(MEASURED 31.04')
NE	12" MAPLE	72.0'	(MEASURED 72.0')
SOUTH	12" HICKORY	54.3'	(MEASURED 54.3')

Ratified by Peer Group in accordance with P.A. 345, 1990


RATIFIED BY GENESEE COUNTY PEER GROUP DECEMBER 28, 1994

Co. Rep. Paul D. Carlson  
Date 12-28-94

**C. Description of monument for corner and accessories established to perpetuate locating the position of the corner:**

SET STANDARD GENESEE COUNTY MONUMENT IN MONUMENT BOX

N60°E	SET P.K. & GC TAG - 24" MAPLE	70.65'
SOUTH	9" CORNER POST	25.33'
S45°W	SET P.K. & GC TAG IN 22" MAPLE	35.75'
NORTH	FOUND NAIL & TAG IN 9" COR. POST	31.04'
SOUTH	SET NAIL & GC TAG IN 20" HICKORY	54.3'
NE	FOUND NAIL & TAG IN 20" MAPLE	72.0'

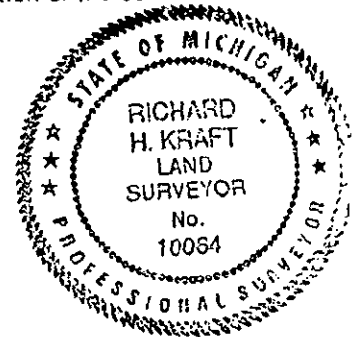

Signed by Richard H. Kraft Date DECEMBER 31, 1994  
Surveyor's Michigan License No. 10064