

**SURVEY &
REMONUMENTATION**

APR 27 1995

1994 REMONUMENTATION PROGRAM
LAND CORNER RECORDATION CERTIFICATE
Filing Requirement of Act 74, Mich. P.A. 1970

For corners in
COMMISSION
GENESEE
(County)

Located In: Corner Code = E-3


	GAINES		
	T 6N	R 5E	E-3
1. Public Land Survey	T _____	R _____	_____
	T _____	R _____	_____
	T _____	R _____	_____
	T _____	R _____	_____
2. Property Controlling In Section	S _____	T _____	R _____
	S _____	T _____	R _____
3. Miscellaneous Property in Sec.	S _____	T _____	R _____
	S _____	T _____	R _____

FEB 16 7 37 AM '95

7779

Register of Deeds Stamp & File Number

4. Lot No. _____, Recorded Plat _____
5. Private Claims _____

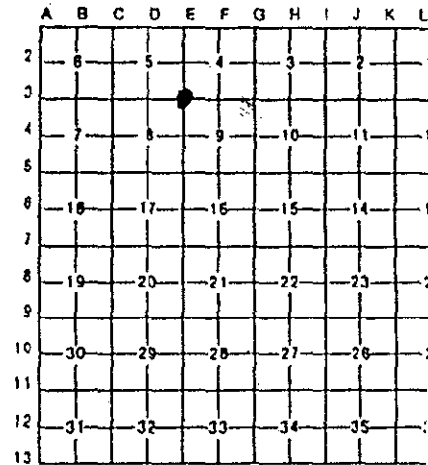

DAVID J. KENNEY, PS, In a field survey on, NOVEMBER 8, 19 94, do hereby certify that under requirements of P.A. 74, Michigan P.A. of 1970, the corner points mentioned in lines 1 and 2 above were in conformance with regulations and rules therelore as required in the current manual of survey instructions of the United States Department of the Interior, Bureau of Land Management or by a decree of a Court of Law and/or that the corner points mentioned in lines 3, 4 and 5 above were in conformance with the rules of the Michigan Board of Land Surveyors or by a Decree of a Court of Law; established, re-established, monumented, re-monumented, recovered, found as expressed below:

NOTE: Not more than 4 corners, all in the same town and range, may be recorded on this certificate.

A. Description of original monument and accessories and/or subsequent restoration:

- 1823 GLO; JOHN MULLETT, D.S. - SET POST - NO ACCESSORIES
- 1878 WILLIAM SEARS - FOUND HUB - 2 ACCESSORIES
- 1920'S GCRC - CORNER NOT IDENTIFIED - 7 ACCESSORIES
- 1977 LCRC, KENNETH DUNTON, R.L.S. - FOUND 1/2" RE-ROD - 3 ACCESSORIES'

B. Description of corner evidence found and/or method applied in restoring or reestablishing corner:

1994 GENESEE COUNTY REMONUMENTATION PROGRAM

- FOUND 1/2" IRON
- 2 ACCESSORIES FROM GCRC 1920'S
- 1 ACCESSORY FROM LCRC 1977

Ratified by Peer Group in accordance with P.A. 345, 1990

Co. Rep. David B. Carlson

Date 12-28-94

RATIFIED BY GENESEE COUNTY PEER GROUP DECEMBER 28, 1994

C. Description of monument for corner and accessories established to perpetuate locating the position of the corner:

SET STANDARD GENESEE COUNTY MONUMENT

ACCESSORIES:

- N 45°E 58.3' SW CORNER ROAD SIGN
- S45°E 40.1' SET P.K. & GC TAG IN 6" MAPLE
- S10°W 16.62' WEST LEG OF ARROW BOARD SIGN
- N15°W 54.02' FOUND DELTA CAP IN POWER POLE



Signed by David J. Kenney Date DECEMBER 31, 1994
Surveyor's Michigan License No. 39083