

SURVEY & REMONUMENTATION

MAY 20 1997

MASTER LIBER 3432 PAGE 148

1996 REMONUMENTATION PROGRAM
LAND CORNER RECORDATION CERTIFICATE
Filing Requirement of Act 74, Mich. P.A. 1970

For corners in

Genesee _____ Located In: _____ Corner Code: #/ #
 (County)

1. Public Land Survey T 6N R 5E E-5
 T _____ R _____
 T _____ R _____
 T _____ R _____

2. Property Controlling S _____ T _____ R _____
 in Section S _____ T _____ R _____

3. Miscellaneous S _____ T _____ R _____
 Property in Sec. S _____ T _____ R _____

4. Lot No. _____, Recorded Plat _____

5. Private Claims _____

RECORDED
 REGISTERED
 Dec 19 10 14 AM '96
 81555
 Register of Deeds Stamp & File Number
Handwritten initials and notes

I, Kevin B. Cleaver, P.S., in a field survey on June 3, 19 96, do hereby certify that under requirements of P.A. 74, Michigan P.A. of 1970, the corner points mentioned in lines 1 and 2 above were in conformance with regulations and rules therofore as required in the current manual of survey instructions of the United States Department of the Interior, Bureau of Land Management or by a decree of a Court of Law and/or that the corner points mentioned in lines 3, 4 and 5 above were in conformance with the rules of the Michigan Board of Land Surveyors or by a Decree of a Court of Law; established, re-established, monumented, re-monumented, recovered, found as expressed below:

NOTE: Not more than 4 corners, all in the same town and range, may be recorded on this certificate.

| | | | | | | | | | | | | |
|----|----|----|----|----|----|----|---|---|---|---|---|---|
| A | B | C | D | E | F | G | H | I | J | K | L | N |
| 2 | 6 | 5 | 4 | 3 | 2 | 1 | | | | | | |
| 3 | | | | | | | | | | | | |
| 4 | 7 | 8 | 9 | 10 | 11 | 12 | | | | | | |
| 5 | | | | | | | | | | | | |
| 6 | 18 | 17 | 16 | 15 | 14 | 13 | | | | | | |
| 7 | | | | | | | | | | | | |
| 8 | 19 | 20 | 21 | 22 | 23 | 24 | | | | | | |
| 9 | | | | | | | | | | | | |
| 10 | 30 | 29 | 28 | 27 | 26 | 25 | | | | | | |
| 11 | | | | | | | | | | | | |
| 12 | 31 | 32 | 33 | 34 | 35 | 36 | | | | | | |
| 13 | | | | | | | | | | | | |

A. Description of original monument and accessories and/or subsequent restoration:

May 23, 1823 Set post with two (2) accessories
 Jan. 5, 1984 Certified survey in Liber 2181, Pages 315 and 316, found 5/8" re-rod, with four (4) accessories
 June, 1990 Certified survey in Liber 2400, Page 529, with three (3) accessories
 Feb. 5, 1994 L.C.R.C., in Liber 2525, Page 683, found 5/8" rod, with four (4) accessories

Ratified by Peer Group in accordance with P.A. 345, 1990
 Co. Rep. Carl Carlson
 Date Jan 3, 1996

B. Description of corner evidence found and/or method applied in restoring or reestablishing corner:

Found a 5/8" re-rod in gravel road; found two (2) of the 1984 accessories; found four (4) of the 1994 accessories.


The monument found was ratified by the Genesee County Peer Review Committee on January 3, 1996, with the monument is to be set with the 1996 remonumentation program, due to existing frost conditions.

C. Description of monument for corner and accessories established to perpetuate locating the position of the corner:

Set in concrete the standard Bernsten monument SS-A-5-BR-30, with 3 1/4" brass cap stamped Genesee County Remonumentation Corner 1995, #29242, over 5/8" re-rod in gravel road.

N 50° W 41.65' Found notch in north rim of manhole
 N 50° E 41.70' Found chiseled "X" top north end of 12" concrete culvert
 S 50° W 46.27' Found nail/tag in north face of dead elm
 S 38° E 47.27' Found re-rod, L.S. #35992
 N 30° W 44.24' Set survey tag in northeast face of anchor post

Signed by Kevin Banfield Cleaver
 Surveyor's Michigan License No. 29242

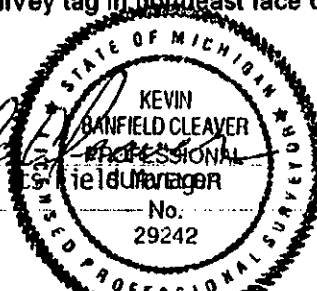

Date JUNE 3, 1996