

REMONUMENTATION

DEED LIBER 2565 PAGE 871

APR 27 1995

COMMISSION

1994 REMONUMENTATION PROGRAM
LAND CORNER RECORDATION CERTIFICATE
Filing Requirement of Act 74, Mich. P.A. 1970

For corners in

GENESEE
(County)


Located In:
GAINES

Corner Code: EG3

- 1. Public Land Survey T 6N R 5E
- T _____ R _____
- T _____ R _____
- T _____ R _____
- 2. Property Controlling S _____ T _____ R _____
- in Section S _____ T _____ R _____
- 3. Miscellaneous S _____ T _____ R _____
- Property in Sec. S _____ T _____ R _____

RECORDED
FEB 16 7 37 AM '95
7781
Register of Deeds Stamp & File Number

- 4. Lot No. _____, Recorded Plat _____
- 5. Private Claims _____

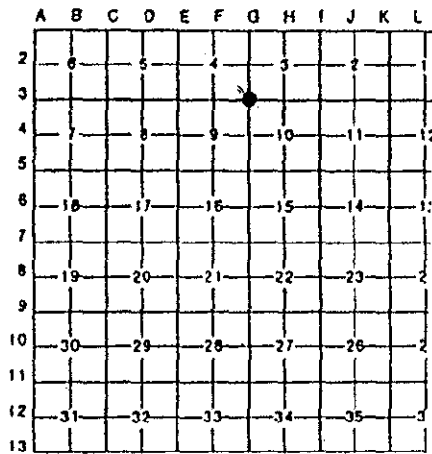

DAVID J. KENNEY, P.S. in a field survey on NOVEMBER 9, 19 94, do hereby certify that under requirements of P.A. 74, Michigan P.A. of 1970, the corner points mentioned in lines 1 and 2 above were in conformance with regulations and rules therefore as required in the current manual of survey instructions of the United States Department of the Interior, Bureau of Land Management or by a decree of a Court of Law and/or that the corner points mentioned in lines 3, 4 and 5 above were in conformance with the rules of the Michigan Board of Land Surveyors or by a Decree of a Court of Law; established, re-established, monumented, re-monumented, recovered, found as expressed below:

NOTE: Not more than 4 corners, all in the same town and range, may be recorded on this certificate.

A. Description of original monument and accessories and/or subsequent restoration:

- 1823 GLO; JOHN MULLETT, D.S. - SET POST - NO ACCESSORIES
- 1878 WILLIAM B. SEARS, D.C.S. - FOUND POST, MEASURED SE COR. TO S 1/4 COR.
- 1988 LCRC, SHELDON BROWN, R.L.S. - SET 1/2" RE-ROD - 4 ACCESSORIES
- 1991 LCRC, CARL CARLSON, R.L.S. - FOUND 1/2" RE-ROD - 3 ACCESSORIES
- 1992 CARL CARLSON, R.L.S. - FOUND 1/2" RE-ROD - 4 ACCESSORIES

B. Description of corner evidence found and/or method applied in restoring or reestablishing corner:

1994 GENESEE COUNTY REMONUMENTATION PROGRAM

- FOUND 1/2" RE-ROD, CAP #9189
- 3 ACCESSORIES FROM LCRC 1988
- 3 ACCESSORIES FROM SURVEY 1992

Ratified by Peer Group in accordance with R.A. 345, 1990
Co. Rep. Carl D. Carlson
Date 12-28-94


RATIFIED BY GENESEE COUNTY PEER GROUP DECEMBER 28, 1994

C. Description of monument for corner and accessories established to perpetuate locating the position of the corner:

SET STANDARD GENESEE COUNTY MONUMENT

ACCESSORIES:

- N30°W 75.60' SET P.K. & GC TAG IN W. FACE 24" PINE
- S25°W 32.97' SET P.K. & GC TAG IN TOP CENTER OF S. GUARDRAIL
- S85°E 12.28' NW CORNER HEADWALL
- S40°E 19.28' SW CORNER HEADWALL
- 2688.62' CALCULATED S 1/4 COR. TO SE COR.

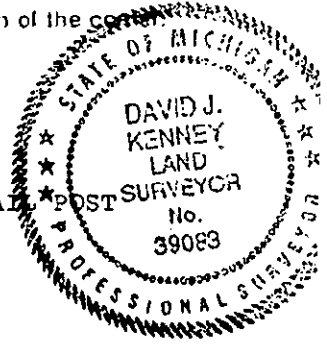

Signed by David J. Kenney Date DECEMBER 31, 1994
Surveyor's Michigan License No. 39083