

MAY 20 1997

COMMISSION

1996 REMONUMENTATION PROGRAM
LAND CORNER RECORDATION CERTIFICATE
Filing Requirement of Act 74, Mich. P.A. 1970

MASTER
LIBER

3432 PAGE

145

GENESEE COUNTY
REGISTERED

DEC 19 10 14 AM '96

RECORDED
REGISTERED

For corners in

Genesee

(County)

Located In:

Corner Code #

1. Public Land Survey

T 6N R 5E

G-5

T _____ R _____

T _____ R _____

T _____ R _____

2. Property Controlling
in Section

S _____ T _____ R _____

S _____ T _____ R _____

3. Miscellaneous

S _____ T _____ R _____

Property in Sec.

S _____ T _____ R _____

4. Lot No. _____, Recorded Plat _____

5. Private Claims _____

81552

Register of Deeds Stamp & File Number

G.O. find file

I, Kevin B. Cleaver, P.S., in a field survey on June 3, 19 96

do hereby certify that under requirements of P.A. 74, Michigan P.A. of 1970, the corner points mentioned in lines 1 and 2 above were in conformance with regulations and rules therefore as required in the current manual of survey instructions of the United States Department of the Interior, Bureau of Land Management or by a decree of a Court of Law and/or that the corner points mentioned in lines 3, 4 and 5 above were in conformance with the rules of the Michigan Board of Land Surveyors or by a Decree of a Court of Law, established, re-established, monumented, re-monumented, recovered, found as expressed below:

NOTE: Not more than 4 corners, all in the same town and range, may be recorded on this certificate.

A. Description of original monument and accessories and/or subsequent restoration:

May 24, 1823, GLO
Date ?

Set post, with no accessories
Old Gould Engineering, Inc., records, found stone,
with five (5) accessories

Feb. 2, 1973 ?

L.C.R.C., Liber 1977, Page 788, re-rod, with three (3)
accessories

April 23, 1973

Certified survey, Liber 1897, Page 347, found re-rod, with
four (4) accessories

Ratified by Peer Group in
accordance with P.A. 345, 1990

Co. Rep. Carl Carlson
Date Jan. 3, 1996

B. Description of corner evidence found and/or method applied in restoring or reestablishing corner:

Found rod with Cornerstone cap in gravel; found two (2) of the February 2, 1973, accessories; found four (4) of the April 23, 1973 accessories.


The monument found was ratified by the Genesee County Peer Review Committee on January 3, 1996, as the accepted corner. This corner is to be set with the 1996 remonumentation corners due to the existing frost conditions.

C. Description of monument for corner and accessories established to perpetuate locating the position of the corner:

Set in concrete the standard Bernsten monument SS-A-5-BR-30, with 3 1/4" brass cap stamped Genesee County Remonumentation Corner 1995, #29242 over a rod and cap in gravel road.

S 45° E	45.07'	Found Delta Engineering tag in the southwest face of power pole
N 30° E	55.45'	Found Delta Engineering tag in the southeast face of power pole
N 28° W	64.37'	Set Genesee County remon. tag in the northeast face of 8" oak
N 75° W	112.58'	Found Delta Engineering tag in the south face of 20" oak
S 55° W	117.37'	Set survey point tag in north face of 24" twin hickory

Signed by Kevin Banfield Cleaver
Surveyor's Michigan License No. 29242

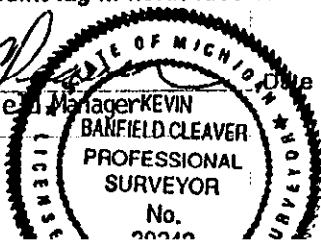

JUNE 3, 1996