

**SURVEY &
REMONUMENTATION**

DEED LIBER 2565 PAGE 873

1994 REMONUMENTATION PROGRAM

APR 27 1995


LAND CORNER RECORDATION CERTIFICATE
Filing Requirement of Act 74, Mich. P.A. 1970

For corners in **COMMISSION**

GENESEE (County)	Located In: GAINES	Corner Code #1
1. Public Land Survey	T 6N R 5E	I-3
	T _____ R _____	_____
	T _____ R _____	_____
	T _____ R _____	_____
2. Property Controlling In Section	S _____ T _____ R _____	_____
	S _____ T _____ R _____	_____
3. Miscellaneous Property In Sec.	S _____ T _____ R _____	_____
	S _____ T _____ R _____	_____

RECORDED
FEB 16 7 37 AM '95
REGISTERED
778
Register of Deeds Stamp & File Number

4. Lot No. _____, Recorded Plat _____
5. Private Claims _____

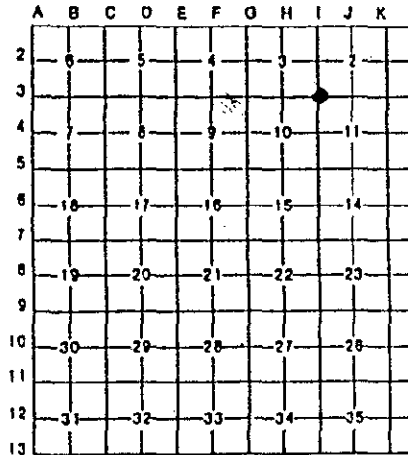

DAVID J. KENNEY, PS in a field survey on, NOVEMBER 9, 19 94 do hereby certify that under requirements of P.A. 74, Michigan P.A. of 1970, the corner points mentioned in lines 1 and 2 above were in conformance with regulations and rules therefore as required in the current manual of survey instructions of the United States Department of the Interior, Bureau of Land Management or by a decree of a Court of Law and/or that the corner points mentioned in lines 3, 4 and 5 above were in conformance with the rules of the Michigan Board of Land Surveyors or by a Decree of a Court of Law; established, re-established, monumented, re-monumented, recovered, found as expressed below:

NOTE: Not more than 4 corners, all in the same town and range, may be recorded on this certificate.

A. Description of original monument and accessories and/or subsequent restoration:

- 1823 GLO; JOHN MULLETT, D.S. - SET POST - NO ACCESSORIES
- GCRG - FOUND 3/4" PIPE - 4 ACCESSORIES
- 1966 GCRG - FOUND 3/4" PIPE - 4 ACCESSORIES
- 1973 LCRC, KAROL PIOTROWSKI, R.L.S. - FOUND 2" PIPE IN MONUMENT BOX - 3' ACCESSORIES
- 1987 CARL CARLSON, R.L.S. - FOUND 1" ROD IN MONUMENT BOX - 1 ACCESSORY

B. Description of corner evidence found and/or method applied in restoring or reestablishing corner:

1994 GENESEE COUNTY REMONUMENTATION PROGRAM
FOUND 1" IRON IN MONUMENT BOX
2 ACCESSORIES LCRC 1973
1 ACCESSORY, C. CARLSON 1987


Ratified by Peer Group in accordance with P.A. 345, 1990
Co. Carl H. Carlson
Date 12-28-94

RATIFIED BY GENESEE COUNTY PEER GROUP DECEMBER 28, 1994

C. Description of monument for corner and accessories established to perpetuate locating the position of the corner:

SET STANDARD GENESEE COUNTY MONUMENT IN MONUMENT BOX

- ACCESSORIES:
- N45°E 46.1' SET P.K. & GC CAP IN POWER POLE
 - S10°W 28.05' NOTCH IN END OF 30" CMP
 - N20°W 34.25' END OF 30" CMP
 - N10°W 51.00' SET P.K. & GC TAG IN POWER POLE
 - N45°W 86.28' CENTER 12" WALNUT
 - S10°W 57.80' SET NAIL & GC TAG IN CENTER 12" ASH

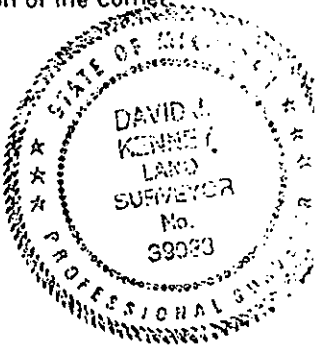

Signed by David J. Kenney Date DECEMBER 31, 1994

Surveyor's Michigan License No. 39083