

MAR 23 2000

Handwritten signature

SECTION

LAND CORNER RECORDATION CERTIFICATE
Filing Requirement of Act 74, Mich. P.A. 1970

DEC 21 2 46 PM '99

For corners in

Genesee Located In: Gaines Corner Code # I-6
(County)

GENESEE COUNTY
REGISTER OF DEEDS

MASTER LIBER 4355 PAGE 87

109071

filed & rec 900
Register of Deeds Stamp & File Number

- 1. Public Land Survey T 6N R 5E I-6
T _____ R _____
- 2. Property Controlling S _____ T _____ R _____
in Section S _____ T _____ R _____
- 3. Miscellaneous S _____ T _____ R _____
Property in Sec. S _____ T _____ R _____

- 4. Lot No. _____, Recorded Plat _____
- 5. Private Claims _____

I, Gilbert G. Bonno, P.S., in a field survey on November 11 19 99, do hereby certify that under requirements of P.A. 74, Michigan P.A. of 1970, the corner points mentioned in lines 1 and 2 above were in conformance with regulations and rules therefore as required in the current manual of survey instructions of the United States Department of the Interior, Bureau of Land Management or by a decree of a Court of Law and/or that the corner points mentioned in lines 3, 4 and 5 above were in conformance with the rules of the Michigan Board of Land Surveyors or by a Decree of a Court of Law; established, re-established, monumented, re-monumented, recovered, found as expressed below:

1	A	B	C	D	E	F	G	H	I	J	K	L
2	6	5	4	3	2	1						
3												
4	7	8	9	10	11	12						
5												
6	18	17	16	15	14	13						
7												
8	19	20	21	22	23	24						
9												
10	30	29	28	27	26	25						
11												
12	31	32	33	34	35	36						
13												

NOTE: Not more than 2 corners, all in the same town and range, may be recorded on this certificate.

A. Description of original monument and accessories and/or subsequent restoration:

1823, GLO - John Mullet, D.S., set wood post and two accessories. Measured I-7 to I-6 and I-6 to I-5.
1888, GCSR, (large book) P 52 - Moses Middleton, set stone. Measured I-6 to H-6 I-6 to I-5.
1999, FSE witnesses project #19763, Fnd "T" bar in mon box and four new witnesses.
1999 FSE sketch project #19763, Fnd "T" bar in mon box, measured I-6 to I-7.
Undated sketch from FSE, Fnd "T" bar in mon box, three new witnesses.

B. Description of corner evidence found and/or method applied in restoring or reestablishing corner:

1999 Remon - found "T" bar in mon box in centerline Seymour Road opposite the occupied fence line to the east and four witnesses from the 1999 FSE survey, (N86E 44.18' FSE N/T in W. face of 6" Crab tree, N33E 74.19' CHC N/T in E face quad (16"-16"-10"-8") poplar, West 53.29' FSE N/T in east face 10" tree, N43W 73.05' CHC N/T in NE face 12" tree).

In the 1823 GLO survey by John Mullet, a wood post is indicated as the corner, with two accessories, neither of which exists today. Two measurements shown I-7 to I-6, 40 chains (2640 feet) and I-6 to I-5 40 chains (2640 feet). In the 1888 Genesee County Surveyor Records (large book), page 52 by Moses Middleton, a stone is indicated as the corner, with two measurements shown, I-6 to I-5 = 40.18 chains (2651.88 feet). In the 1999 FSE survey for project #19763, a T-bar is indicated as the corner, with one measurement, I-6 to I-7 = 2655.43 feet. Four accessories are noted, all four of which are still in place and compare within 0.02 to 0.06 feet of record. In a undated sketch from FSE, a T-bar is indicated as the corner, with four measurements, I-6 to I-7 = 2649.515 feet, 5.915 feet shorter than the 1999 record; I-6 to H-6 = 1651.83 feet, 1.293 feet longer than the 1888 record; I-6 to G-6 = 5382.689 feet and I-6 to I-5 = 2649.515 feet; 2.365 feet shorter than the 1888 record.

In the 1999 remonumentation program, I am finding a T-bar in a monument box as the corner, with two measurements I-6 to I-7 = 2655.29 feet; within 0.14 feet of the 1999 FSE record, and I-6 to I-5 = 2649.50 feet; 2.37 feet shorter than the 1888 record; and 0.005 feet of the undated FSE record. Four accessories were recovered and measured. One measured to the exact record and three measured 0.02 to 0.06 feet of record. Based on the above evidence, I accept the "T" iron in the monument box as the best available evidence of the position of the original corner.


C. Description of monument for corner and accessories established to perpetuate locating the position of the corner:

N86°E 44.24' ESE nail and tag in W. face 6' Crab apple
N33°E 74.22' CHC nail and tag in E. face quad (16"-16"-10"-8")
Poplar.
West 53.27' FSE nail and tag in E. face 10" tree
N43°W 73.07' CHC nail and tag in NE face 12" tree
West 44.43' Metal fence

Ratified by the Genesee County Peer Group
December 1, 1999
I set the Standard Bernsten Monument SS-A-5-BR-30
(3 1/4" D. Brass cap stamped "Genesee County
Remonumentation Corner 32332, 1999") with 30" x 2 3/8"
O.D. stainless steel tube set in monument box.

Ratified by Peer Group in
accordance with P.A. 345, 1990

Co. Rep. *[Signature]*
Date 12-1-99

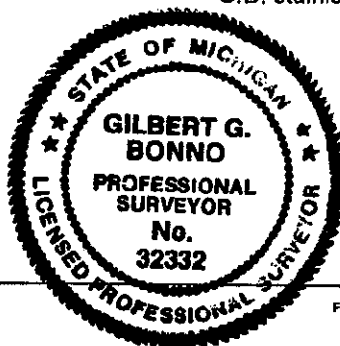

Signed by *[Signature]*
Surveyor's Michigan License No. #32332

Date 12-15-99