

APR 27 1995

1994 REMONUMENTATION PROGRAM

LAND CORNER RECORDATION CERTIFICATE

Filing Requirement of Act 74, Mich. P.A. 1970

COMMISSION

For corners in

GENESEE (County)	Located In: GAINES	Corner Code #/
1. Public Land Survey	T 6N R 5E	J-3
	T R	
	T R	
	T R	
2. Property Controlling In Section	S T R	
	S T R	
3. Miscellaneous Property In Sec.	S T R	
	S T R	

RECORDED
REGISTERED
FEB 16 7 37 AM '95
7784
Register of Deeds Stamp & File Number

4. Lot No. _____, Recorded Plat _____
 5. Private Claims _____

I, DAVID J. KENNEY, PS, in a field survey on NOVEMBER 9, 19 94, do hereby certify that under requirements of P.A. 74, Michigan P.A. of 1970, the corner points mentioned in lines 1 and 2 above were in conformance with regulations and rules therefore as required in the current manual of survey instructions of the United States Department of the Interior, Bureau of Land Management or by a decree of a Court of Law and/or that the corner points mentioned in lines 3, 4 and 5 above were in conformance with the rules of the Michigan Board of Land Surveyors or by a Decree of a Court of Law; established, re-established, monumented, re-monumented, recovered, found as expressed below:

NOTE: Not more than 4 corners, all in the same town and range, may be recorded on this certificate.

A. Description of original monument and accessories and/or subsequent restoration:

- 1823 GLO; JOHN MULLETT, D.S. - SET POST - NO ACCESSORIES
- 1920 GCRC - FOUND 1 1/2" PIPE - 4 ACCESSORIES
- GCRC - FOUND 1 1/2" PIPE - 6 ACCESSORIES
- 1973 LCRC, KAROL PIOTROWSKI, R.L.S. - FOUND 1/2" PIPE - SET R.R. SPIKE, - 4 ACCESSORIES

B. Description of corner evidence found and/or method applied in restoring or reestablishing corner:

1994 GENESEE COUNTY REMONUMENTATION PROGRAM

FOUND 1" IRON IN MONUMENT BOX

- 2 ACCESSORIES GCRC 1920'S
- 2 ACCESSORIES LCRC 1973

Ratified by Peer Group in accordance with P.A. 345, 1990

Co. Rep. Paul D. Carlson
Date 12-28-94


RATIFIED BY GENESEE COUNTY PEER GROUP DECEMBER 28, 1994

C. Description of monument for corner and accessories established to perpetuate locating the position of the corner:

SET STANDARD GENESEE COUNTY MONUMENT IN MONUMENT BOX

ACCESSORIES:

- N45°E 44.75' SET P.K. & GC TAG IN 12" PINE
- S60°E 80.33' FOUND NAIL & TAG (CARLSON) IN POWER POLE
- S40°W 34.33' FOUND "X" IN 18" CMP
- N 5°W 33.75' FOUND NAIL & CAP (S. BROWN) IN TELEPHONE POLE
- S15°E 82.75' NE CORNER HOUSE PORCH
- N20°E 61.03' CENTER 10" PINE

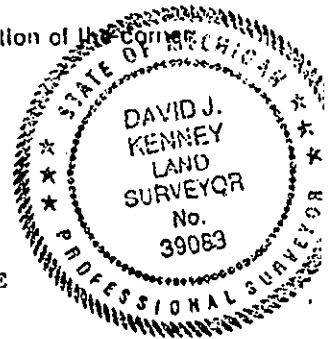

Signed by David J. Kenney Date DECEMBER 31, 1994
 Surveyor's Michigan License No. 39083