

SURVEY & REMONUMENTATION

DEED LIBER **2565** PAGE **875**

APR 27 1995

**1994 REMONUMENTATION PROGRAM
LAND CORNER RECORDATION CERTIFICATE
Filing Requirement of Act 74, Mich. P.A. 1970**

For corners **COMMISSION**

<u>GENESEE</u> (County)	Located In:	Corner Code: #/
	GAINES	
1. Public Land Survey	T <u>6N</u> R <u>5E</u>	<u>K-3</u>
	T _____ R _____	_____
	T _____ R _____	_____
	T _____ R _____	_____
2. Property Controlling in Section	S _____ T _____ R _____	_____
	S _____ T _____ R _____	_____
3. Miscellaneous Property in Sec.	S _____ T _____ R _____	_____
	S _____ T _____ R _____	_____

RECORDED
FEB 16 7 37 AM '95
7785
Register of Deeds Stamp & File Number

4. Lot No. _____, Recorded Plat _____
5. Private Claims _____

A	B	C	D	E	F	G	H	I	J	K	L
2	6	5	4	3	2						
3											
4	7	8	9	10	11						
5											
6	18	17	16	15	14						
7											
8	19	20	21	22	23						
9											
10	30	29	28	27	26						
11											
12	31	32	33	34	35						
13											

I, RICHARD H. KRAFT, PS in a field survey on, NOVEMBER 10, 19 94, do hereby certify that under requirements of P.A. 74, Michigan P.A. of 1970, the corner points mentioned in lines 1 and 2 above were in conformance with regulations and rules therefore as required in the current manual of survey instructions of the United States Department of the Interior, Bureau of Land Management or by a decree of a Court of Law and/or that the corner points mentioned in lines 3, 4 and 5 above were in conformance with the rules of the Michigan Board of Land Surveyors or by a Decree of a Court of Law; established, re-established, monumented, re-monumented, recovered, found as expressed below:

NOTE: Not more than 4 corners, all in the same town and range, may be recorded on this certificate.

A. Description of original monument and accessories and/or subsequent restoration:

- 1823 GLO; JOHN MULLETT, D.S. - SET POST - NO ACCESSORIES
- 1920 GCRC - SET STONE & PIPE - 3 ACCESSORIES
- 1963 HERMAN BATEMAN, R.L.S. - RECORDED PLAT OF BENSON ACRES
- 1969 GCRC - FOUND SURVEYOR TAG UNDER PAVEMENT - 4 ACCESSORIES
- 1973 LCRC, KAROL PIOTROWSKI, R.L.S. - FOUND 1/2" IRON IN MONUMENT BOX - 3 ACCESSORIES

B. Description of corner evidence found and/or method applied in restoring or reestablishing corner:

1994 GENESEE COUNTY REMONUMENTATION PROGRAM
FOUND 1/2" IRON IN MONUMENT BOX
2 ACCESSORIES 1969
3 ACCESSORIES, LCRC 1973


Ratified by Peer Group in accordance with P.A. 345, 1990
Co. Rep. Carl D. Carlson
Date 12-28-94

RATIFIED BY GENESEE COUNTY PEER GROUP DECEMBER 28, 1994

C. Description of monument for corner and accessories established to perpetuate locating the position of the corner:

SET STANDARD GENESEE COUNTY MONUMENT IN MONUMENT BOX
ACCESSORIES:

- N35°E 95.2' TOP CENTER NUT OF FIRE HYDRANT
- N45°E 67.0' FOUND P.K. & WASHER IN POWER POLE
- S45°W 61.5' FOUND NAIL AND CAP (RLS) IN POWER POLE
- N45°E 59.1' FOUND NAIL AND CAP (RLS) IN POWER POLE

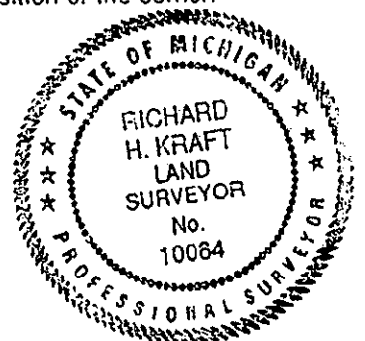

Signed by Richard H. Kraft Date DECEMBER 31, 1994
Surveyor's Michigan License No. 10064