


MAR 23 2000

SECTION

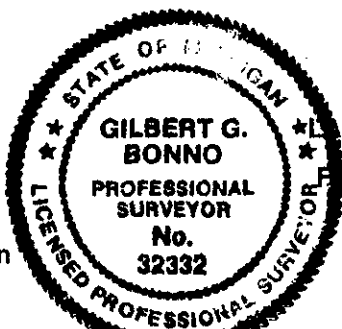

LAND CORNER RECORDATION CERTIFICATE
Filing Requirement of Act 74, Mich. P.A. 1970

Dec 21 2 46 PM '99

For corners in

Genesee (County) Locust Point Twp Saines Township Corner Code # K-4

GENESEE COUNTY
REGISTER OF DEEDS

MASTER LIBER 4355 PAGE 78

109064

filed & rec 11⁰⁰
Register of Deeds Stamp & File Number

- 1. Public Land Survey T 6N R 5E
- 2. Property Controlling in Section S ___ T ___ R ___
- 3. Miscellaneous Property in Sec. S ___ T ___ R ___

- 4. Lot No. ____, Recorded Plat _____
- 5. Private Claims _____

I, Gilbert G. Bonno, P.S., in a field survey on November 17, 1999 do hereby certify that under requirements of P.A. 74, Michigan P.A. of 1970, the corner points mentioned in lines 1 and 2 above were in conformance with regulations and rules therefore as required in the current manual of survey instructions of the United States Department of the Interior, Bureau of Land Management or by a decree of a Court of Law and/or that the corner points mentioned in lines 3, 4 and 5 above were in conformance with the rules of the Michigan Board of Land Surveyors or by a Decree of a Court of Law; established, re-established, monumented, re-monumented, recovered, found as expressed below:

NOTE: Not more than 2 corners, all in the same town and range, may be recorded on this certificate.

	A	B	C	D	E	F	G	H	I	J	K	L
1												
2	6		5		4		3		2			
3												
4	7		8		9		10		11			
5												
6	18		17		16		15		14			
7												
8	19		20		21		22		23			
9												
10	30		29		28		27		26			
11												
12	31		32		33		34		35			
13												

A. Description of original monument and accessories and/or subsequent restoration:

1823, GLO by John Mullet, D.S., set wood post and two accessories
1912 GCRC dwg #754, Stone & iron, K-4 to K-3 = 2640'; K-4 to K-5 = 2643.5'
1973 Act 132 by Sheldon R. Brown #17613 recorded on L. 1890, P.8, PK nail, three accessories, found one, S30W, 60.72
Nail in 7" Pine (R), 60.40 (M), K-4 to K-3 = 2642.17'
1973 Sketch from FSE, None given, K-4 to K-3 = 2642.17'; K-4 to K-5 = 2643.56'
1978 ROWE witness card, "+" on stone, glass, iron, 4 accessories noted, all gone
(Cont'd on back)

B. Description of corner evidence found and/or method applied in restoring or reestablishing corner:

1999 REMON - Found rod with unreadable cap and a few pieces of broken glass.

In 1823, J. Mullet indicates setting a post with two accessories. I found no evidence of any survey work being performed from the original GLO survey in 1823 until 1912. In 1912, the GCRC drawings indicate a found stone and iron; K-4 to K-3 2640 feet and K-5 to K-4, 2643.5 feet. In 1973, Sheldon Brown measured 2642.17 feet from K-4 to K-3. Three accessories were noted, one of which exists in 1999, S30°W, 60.72 feet nail in 7" Pine (R); 1999 found scar on Pine, 60.40 feet within 0.32 feet. In 1973, FSE measurements between K-4 to K-5 = 2643.56 feet, within 0.06 feet of the 1912 measurement the corner was monumented by a PK nail at this time. In 1978, ROWE witness card listed four trees as accessories, one of which was found. The corner was described as a "+" on stone, glass and iron, some glass was recovered at the position. In 1990, a Rowe witness card listed five accessories, I recovered all of five accessories which checked within 0.20 to 0.41 feet of record. The card indicates a found PK with flagging, which was replaced with a rod and cap #33134. In 1997, a Rowe witness card lists four accessories, all of which exist in 1999 and compare within 0.00 to 0.03 of record the corner was described as a found rod with an unreadable cap in the centerline of the road. In 1999, FSE measured from K-4 to K-5, 2642.94 feet, which is 0.62 feet from their 1973 measurement.
(Cont'd on back)

C. Description of monument for corner and accessories established to perpetuate locating the position of the corner

- N84W 44.53' Fnd tag #11192 in N fc TP
- S88W 40.70' Fnd tag #22442 in S fc 14" Hickory
- S30W 60.71' Fnd spike & flag in SE fc 12" Pine
- N88E 39.13' Fnd spike & flag in N fc 6" Ash
- S50W 22.54' Fnd 1/2" rod no cap in W edge of gravel shoulder
- N30W 104.52' Center of gas pipeline sign post
- N30E 100.87' Center of gas pipeline sign post
- S35W 60.61' Fnd N&T in E fc 10" Red Pine

I set the Standard Bernsten Monument SS-A-5-BR-30 (3/4" D. Brass cap Stamped "Genesee County Remonumentation Corner 32332, 1999") with 30" x 2 3/8" O.D. Stainless Steel tube with plastic base.

Ratified by the Genesee County Peer Group December 1, 1999.

Signed by Gilbert G. Bonno
Surveyor's Michigan License No. 32332

Ratified by Peer Group in accordance with P.A. 345, 1990 12-15-99

Co. Rep. Carl Calum
FORM APPROVED BY MICHIGAN STATE BOARD OF LAND SURVEYORS, JAN. 28, 1977
REVISED MAY 14, 1977
REVISED JAN. 1999
ADAPTED FOR WORD PROCESSING MARCH 1999

SURVEY &
REMONUMENTATION

MAR 23 2000

SECTION

MASTER
LIBER 4355 PAGE

79

A. Description of original monument and accessories and/or subsequent restoration (Continued):

1990 ROWE witness card, Fnd PK/flagging. Replaced with rod & cap #33134, 5 accessories noted, all check well.
1997 ROWE witness card, Fnd rod & cap in CL road, occ edge of field E & W, could not read cap; 4 accessories noted, all check well.
1999 Survey from FSE, none given, K-4 to K-5 = 2642.94' (dbl 1/8)

B. Description of corner evidence found and/or method applied in restoring or reestablishing corner (Continued):

Today in the 1999 remonumentation program I am finding a rod with an unreadable cap in the centerline of Morrish Road. This rod falls in line with a tree line to the east and old farm fence remnants to the west. Upon excavation of this corner a few pieces of broken glass were recovered. (noted in 1978 Rowe witness card)

I accept the found rod with unreadable cap as the best available evidence of the original corner, K-4 T6N-R5E, Gaines Township.